

SURVEY & REMONUMENTATION

FEB 14 1997

COMMISSION

LAND CORNER RECORDATION CERTIFICATE
Filing Requirement of Act 74, Mich. P.A. 1970
KENT COUNTY REMONUMENTATION


For corners in

Kent (County)	Located in:	Gaines Township	Corner Code #
1. Public Land Survey	T <u>5N</u>	R <u>11W</u>	<u>K-5</u>
	T _____	R _____	_____
	T _____	R _____	_____
	T _____	R _____	_____
2. Property Controlling in Section	S _____	T _____	R _____
	S _____	T _____	R _____
3. Miscellaneous Property in Sec.	S _____	T _____	R _____
	S _____	T _____	R _____
4. Lot No. _____, Recorded Plat _____			
5. Private Claims _____			

STATE OF MICHIGAN
 COUNTY OF KENT
 RECEIVED FOR RECORD
 96 AUG -8 AM 8:46
 REG. OF DEEDS
Lucy Standa
9310
 Register of Deeds Stamp & File Number

I, Randy Kolehouse, in a field survey on January 4 19 96, do hereby certify that under requirements of P.A. 74 Michigan P.A. of 1970, the corner points mentioned in lines 1 and 2 above were in conformance with regulations and rules therefore as required in the current manual of survey instructions of the United States Department of the interior, Bureau of Land Management or by a decree of a Court of Law and/or that the corner points mentioned in lines 3, 4 and 5 above were in conformance with the rules of the Michigan Board of Land Surveyors or by a Decree of a Court of Law; established, re-established, monumented, re-monumented, recovered, found as expressed below:

NOTE: Not more than 4 corners, all in the same town and range, may be recorded on this certificate.

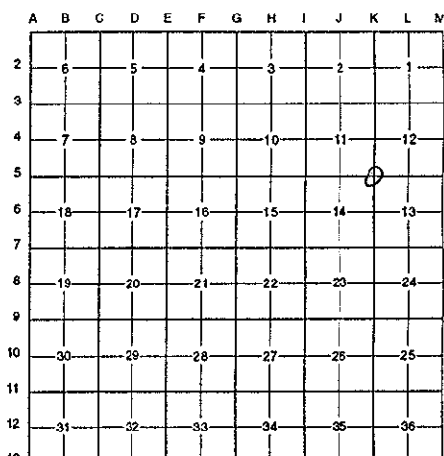

A. Description of original monument and accessories and/or subsequent restoration:

K-5	1831	G.L.O. Notes	Mullett	Set Post
	1963	Witness Map	K.C. Surveyor	3/4" Iron
	1973	L.C.R.C. #415	Medema, Van Kooten & Assoc.	"T" Iron
	1976	L.C.R.C. #959	McPherson	"T" Iron
	1981	L.C.R.C. #2289	Nederveld & Associates	Fnd. "T" Iron / Set K.C. Monument
	1994	L.C.R.C. #7205	Glaza & Associates	K.C. Monument

P.A. 345 1990 KENT COUNTY
 PEER APPROVED 3/7/96
 CHAIRMAN *Henry Huber*

This corner was originally approved by the Kent County Remonumentation Peer Group and monumented by Nederveld & Associates on 8/17/81 and was recorded per L.C.R.C. #2289.

B. Description of corner evidence found and/or method applied in restoring or reestablishing corner:


K-5 Found a Standard Kent County Monument 1.5' M/L West of the C/L of East Paris Avenue (bit.) running North & South and 0.5' M/L South of the C/L of 76th Street (bit.) running East & West per L.C.R.C.'s #2289 and #7205 as set by Nederveld & Associates in place of a "T" iron they found that checked L.C.R.C.'s #415 and #959 ad K.C. Surveyor's records.

L.C.R.C. #2289	L.C.R.C. #7205
"X" top W end 24" concrete culv. S 10° W 171.29'	"X" top of West end of 24" concrete culv. S 10° W 171.29'
"X" top N end 12" concrete culv. N 80° E 80.08'	"X" top of North end of 12" concrete culv. N 80° E 80.08'
Nail & K.C. Remon. tag NE side P. pole N 44° W 41.30'	Nail & K.C. remon tag NE side P. pole N 44° W 41.32'
Nail & K.C. Remon. tag NE side 12" Elm S 44° E 79.25'	Nail & K.C. remon tag NE side 20" Elm S 44° E 79.28'

The selected location is accepted by me and is generally accepted by professional surveyors as the best available evidence of the position of the original corner.

C. Description of monument for corner and accessories established to perpetuate locating the position of the corner:

K-5 Standard Kent County Monument
 "X" top of West end of 24" concrete culv. S 10° W 171.29'
 "X" top of North end of 12" concrete culv. N 80° E 80.08'
 Nail & K.C. remon tag NE side P. pole N 44° W 41.32'
 Nail & K.C. remon tag NE side 20" Elm S 44° E 79.28'

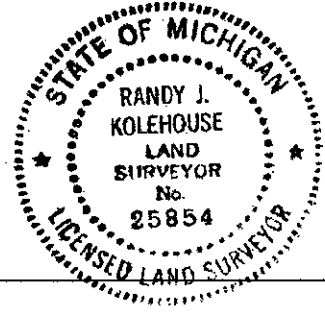

Signed by *Randy J. Kolehouse* Date 7/23/96
 EARTH TECH

Surveyor's Michigan License No. 25854