

FEB 14 1997

COMMISSION

LAND CORNER RECORDATION CERTIFICATE
Filing Requirement of Act 74, Mich. P.A. 1970
KENT COUNTY REMONUMENTATION


For corners in

Table with columns: Kent (County), Located in: Gains Township, Corner Code #. Rows include Public Land Survey, Property Controlling in Section, Miscellaneous Property in Sec.

Register of Deeds Stamp & File Number. Includes stamp: STATE OF MICHIGAN COUNTY OF KENT RECEIVED FOR RECORD 96 AUG -8 AM 8:46 REG. OF DEEDS 9311

4. Lot No. , Recorded Plat
5. Private Claims

I, Randy Kolehouse, in a field survey on December 27 19 95, do hereby certify that under requirements of P.A. 74 Michigan P.A. of 1970, the corner points mentioned in lines 1 and 2 above were in conformance with regulations and rules therefore as required in the current manual of survey instructions of the United States Department of the interior, Bureau of Land Management or by a decree of a Court of Law and/or that the corner points mentioned in lines 3, 4 and 5 above were in conformance with the rules of the Michigan Board of Land Surveyors or by a Decree of a Court of Law; established, re-established, monumented, re-monumented, recovered, found as expressed below:

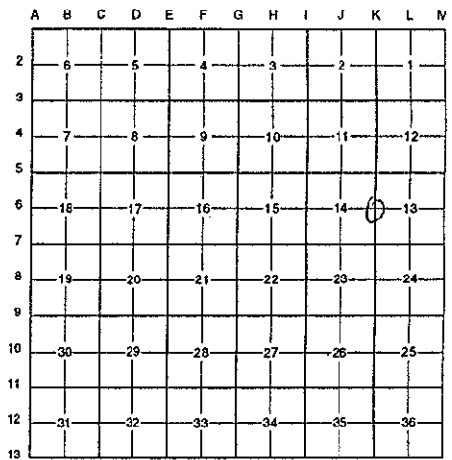

NOTE: Not more than 4 corners, all in the same town and range, may be recorded on this certificate.

A. Description of original monument and accessories and/or subsequent restoration:

Table with columns: K-6, 1831, G.L.O. Notes, Mullet, Set Post, 1961, Witness Map, K.C. Surveyor, Iron, 1976, L.C.R.C. #959, McPherson, 3/4" Iron Pipe, 1982, L.C.R.C. #2837, Jonker Land Surveys, Fnd. 1/2" Iron in 3/4" Iron Pipe / Set K.C. Monument, 1994, L.C.R.C. #7204, Glaza & Associates, K.C. Monument

P.A. 345 1990 KENT COUNTY PEER APPROVED 3/27/96 CHAIRMAN Randy Kolehouse

This corner was originally approved by the Kent County Remonumentation Peer Group and monumented by Jonker Land Surveys on 4/27/82 and was recorded per L.C.R.C. #2837.

B. Description of corner evidence found and/or method applied in restoring or reestablishing corner:

K-6 Found a Standard Kent County Monument 1.5' West of C/L (bit.) of East Paris Avenue running North and South per L.C.R.C.'s #2837 and #7204 as set by Rob Jonker in place of a 1/2" iron they found which checked L.C.R.C.'s #1001 and #959 and K.C. Surveyor's records.

L.C.R.C. #2837

L.C.R.C. #7204


Table comparing L.C.R.C. #2837 and #7204 evidence. #2837: Large spike on N side 48" Oak N 65° W 43.14', Remon. tag on S side 48" Oak N 80° W 42.06', Remon. tag on SE side 24" Maple S 45° W 30.30', Remon. tag on NW side 6" Maple N 60° E 39.34', C/L N-S pvt. E 1.5', On line fence line to W & brush row to E. #7204: K.C. remon tag & nail in NE side 48" Oak N 65° W 42.89', K.C. remon tag & nail in S side 48" Oak N 80° W 41.90' (m. 41.85'), K.C. remon tag & nail in SE side 24" Maple S 45° W 30.21', K.C. remon tag & nail in NW side 10" Maple N 60° E 39.39', C/L North-South pvt. East 1.50', On line fence line to W & brush row to E

The selected location is accepted by me and is generally accepted by professional surveyors as the best available evidence of the position of the original corner.

C. Description of monument for corner and accessories established to perpetuate locating the position of the corner:

K-6 Standard Kent County Monument

- Nail & K.C. remon. tag on NE side 48" Oak N 65° W 42.89'
Nail & K.C. remon. tag on S side 48" Oak N 80° W 41.85'
Nail & K.C. remon. tag on SE side 24" Maple S 45° W 30.21'
Nail & K.C. remon. tag on NW side 10" Maple N 60° E 39.39'

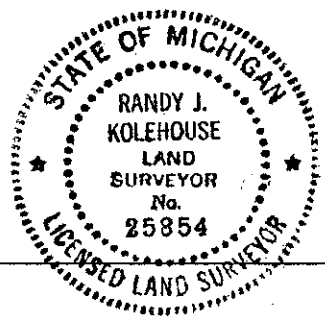

Signed by Randy J. Kolehouse EARTH TECH

Date 7/23/96

Surveyor's Michigan License No. 25854