

**SURVEY & REMONUMENTATION**

FEB 14 1997

COMMISSION

**LAND CORNER RECORDATION CERTIFICATE**  
**Filing Requirement of Act 74, Mich. P.A. 1970**  
**KENT COUNTY REMONUMENTATION**

For corners in

Kent (County)	Located in: Gaines Township	Corner Code #
1. Public Land Survey	T <u>5N</u> R <u>11W</u>	<u>K-7</u>
	T _____ R _____	_____
	T _____ R _____	_____
	T _____ R _____	_____
2. Property Controlling in Section	S _____ T _____ R _____	_____
	S _____ T _____ R _____	_____
3. Miscellaneous Property in Sec.	S _____ T _____ R _____	_____
	S _____ T _____ R _____	_____
4. Lot No. _____, Recorded Plat _____		
5. Private Claims _____		

STATE OF MICHIGAN  
 COUNTY OF KENT  
 RECEIVED FOR RECORD


96 AUG -8 AM 8:47

REG. OF DEEDS  
 9312

Register of Deeds Stamp & File Number

I, Randy Kolehouse, in a field survey on January 4 19 96, do hereby certify that under requirements of P.A. 74 Michigan P.A. of 1970, the corner points mentioned in lines 1 and 2 above were in conformance with regulations and rules therefore as required in the current manual of survey instructions of the United States Department of the interior, Bureau of Land Management or by a decree of a Court of Law and/or that the corner points mentioned in lines 3, 4 and 5 above were in conformance with the rules of the Michigan Board of Land Surveyors or by a Decree of a Court of Law; established, re-established, monumented, re-monumented, recovered, found as expressed below:

**NOTE: Not more than 4 corners, all in the same town and range, may be recorded on this certificate.**

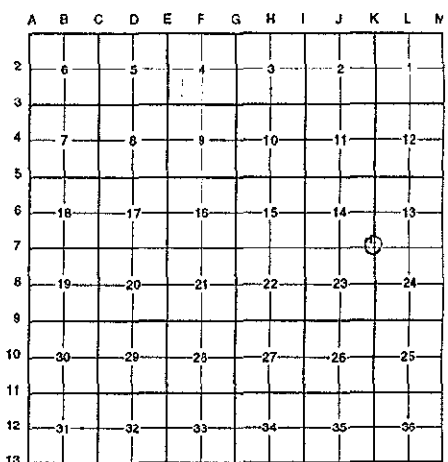

A. Description of original monument and accessories and/or subsequent restoration:

K-7	1831	G.L.O. Notes	Mullett	Set Post
	1942	Witness Map	K.C. Surveyor	1" Iron
	1974	L.C.R.C. #849	Medema, Van Kooten & Assoc.	1" Iron
	1976	L.C.R.C. #959	McPherson	3/4" Iron
	1981	L.C.R.C. #2288	Nederveld & Assoc.	Fnd. 3/4" Iron in Mon. Box / Set K.C. Monument
	1994	L.C.R.C. #7182	Glaza & Associates	K.C. Monument

P.A. 345 1990 KENT COUNTY  
 PEER APPROVED 3/7/96  
 CHAIRMAN Randy Kolehouse

This corner was originally approved by the Kent County Remonumentation Peer Group and monumented by Nederveld & Associates on 8/17/81 and was recorded per L.C.R.C. #2288.

B. Description of corner evidence found and/or method applied in restoring or reestablishing corner:

K-7 Found a Standard Kent County Monument in a monument box 1.5' North and 1.5' West of the C/L intersection of East Paris Avenue (bit.) running North & South and 84th Street (bit.) running East & West per L.C.R.C.'s #2288 and #7182 as set by Nederveld & Associates in place of a 3/4" iron in a monument box they found that checked L.C.R.C.'s #849, #959 and K.C. Surveyor's records.


L.C.R.C. #2288	L.C.R.C. #7182
Nail & K.C. Remon tag SE side P. pole N 43° E 41.29'	Nail & K.C. remon tag in SE side P. pole N 43° E 41.29'
Nail & K.C. Remon tag NE side T. pole S 25° E 51.99'	Nail & K.C. remon tag in NE side T. pole S 25° E 51.99'
"X" in E end conc. culvert S 15° E 67.95'	"X" in East end of concrete clvert S 15° E 67.95'
"X" in W end conc. culvert S 24° W 68.78'	"X" in West end of concrete culvert S 24° W 68.78'
	Nail & K.C. remon. tag in NW side tree clump (6) in 8" trunk S 40° W 73.92' (m. 73.86')

The selected location is accepted by me and is generally accepted by professional surveyors as the best available evidence of the position of the original corner.

C. Description of monument for corner and accessories established to perpetuate locating the position of the corner:

K-7 Standard Kent County Monument in Monument Box

Nail & K.C. remon. tag on SE side P. pole N 43° E 41.29'  
 Nail & K.C. remon. tag on NE side T. pole S 25° E 51.99'  
 "X" in East side of concrete clvert S 15° E 67.95'  
 "X" in West side of concrete culvert S 24° W 68.78'  
 Nail & K.C. remon. tag on N side tree clump (6) in 8" trunk S 40° W 73.86'

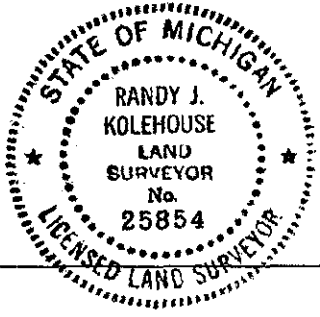

Signed by Randy J. Kolehouse Date 7/23/96  
 EARTH TECH

Surveyor's Michigan License No. 25854