

SURVEY & REMONUMENTATION

FEB 14 1997

COMMISSION

LAND CORNER RECORDATION CERTIFICATE
 Filing Requirement of Act 74, Mich. P.A. 1970
 KENT COUNTY REMONUMENTATION

For corners in

Kent (County)	Located in:	Gaines Township	Corner Code #
1. Public Land Survey	T <u>5N</u>	R <u>11W</u>	<u>K-9</u>
	T _____	R _____	_____
	T _____	R _____	_____
	T _____	R _____	_____
2. Property Controlling in Section	S _____	T _____	R _____
	S _____	T _____	R _____
3. Miscellaneous Property in Sec.	S _____	T _____	R _____
	S _____	T _____	R _____


STATE OF MICHIGAN
 COUNTY OF KENT
 RECEIVED FOR RECORD

96 AUG -8 AM 8:47

REG. OF DEEDS
[Signature]
 9314

Register of Deeds Stamp & File Number

4. Lot No. _____, Recorded Plat _____
 5. Private Claims _____

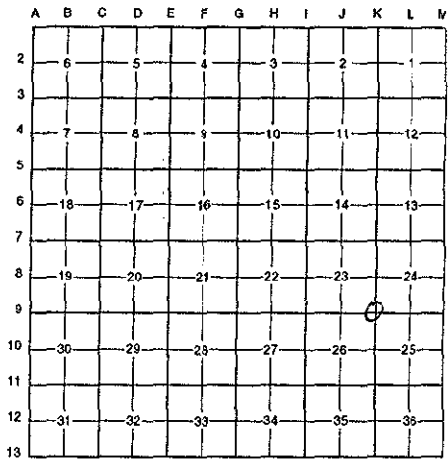

I, Randy Kolehouse, in a field survey on January 3 19 96, do hereby certify that under requirements of P.A. 74 Michigan P.A. of 1970, the corner points mentioned in lines 1 and 2 above were in conformance with regulations and rules therefore as required in the current manual of survey instructions of the United States Department of the interior, Bureau of Land Management or by a decree of a Court of Law and/or that the corner points mentioned in lines 3, 4 and 5 above were in conformance with the rules of the Michigan Board of Land Surveyors or by a Decree of a Court of Law; established, re-established, monumented, re-monumented, recovered, found as expressed below:

NOTE: Not more than 4 corners, all in the same town and range, may be recorded on this certificate.

A. Description of original monument and accessories and/or subsequent restoration:

K-9	1831	G.L.O. Notes	Mullett	Set Post
	N/A	Witness Map	K.C. Surveyor	Stone
	1974	L.C.R.C. #760	Exxel Engineering	1/2" Iron
	1974	L.C.R.C. #849	Medema, Van Kooten & Assoc.	3/4" Iron
	1982	L.C.R.C. #2838	Rob Jonker	Fnd. 1/2" Iron / Set K.C. Monument
	1994	L.C.R.C. #7173	Glaza & Associates	K.C. Monument

P.A. 345 1990 KENT COUNTY
 PEER APPROVED 3/7/96
 CHAIRMAN *[Signature]*

This corner was originally approved by the Kent County Remonumentation Peer Group and monumented by Rob Jonker on 4/22/82 and was recorded per L.C.R.C. #2838.

B. Description of corner evidence found and/or method applied in restoring or reestablishing corner:
 K-9 Found a Standard Kent County Monument at the C/L intersection of 92nd Street (bit.) running East and West and East Paris Avenue (bit.) running North and South per L.C.R.C.'s #760, #2838 and #7173 as set by Rob Jonker in place of a 3/4" iron over a "+" in old pavement (12" below road surface) he found that checked L.C.R.C.'s #760 and #849.

L.C.R.C. #2838	L.C.R.C. #7173
Remon. tag on NW side g. pole N 25° E 65.38'	K.C. remon tag on NW side guy pole N 25° E 65.61'
Remon. tag on E side p. pole N 40° W 84.35'	K.C. remon tag on E side P. pole N 40° W 84.35'
Remon. tag on SW side p. pole S 30° E 60.78'	K.C. remon tag on SW side P. pole S 30° E 60.78'
Remon. tag on SE side p. pole S 50° W 45.88'	K.C. remon tag on SE side P. pole S 50° W 45.88'
Chisled "X" on S end culvert S 70° E 64.05'	
Chisled "X" on N end culvert N 75° E 64.64'	

The selected location is accepted by me and is generally accepted by professional surveyors as the best available evidence of the position of the original corner.

C. Description of monument for corner and accessories established to perpetuate locating the position of the corner:
 K-9 Standard Kent County Monument

Nail & K.C. remon. tag on NW side Guy pole N 25° E 65.61'
 Nail & K.C. remon. tag on E side P. pole N 40° W 84.35'
 Nail & K.C. remon. tag on SW side P. pole S 30° E 60.78'
 Nail & K.C. remon. tag on SE side P. pole S 50° W 45.88'

Signed by *[Signature]*
 EARTH TECH

Date 7/23/96

Surveyor's Michigan License No. 25854

