

**SURVEY & REMONUMENTATION**

FEB 14 1997

**LAND CORNER RECORDATION CERTIFICATE**  
**Filing Requirement of Act 74, Mich. P.A. 1970**  
**KENT COUNTY REMONUMENTATION**

For corners in

**COMMISSION**


Kent (County)	Located in: Gains Township	Corner Code #
1. Public Land Survey	T <u>5N</u> R <u>11W</u>	<u>K-10</u>
	T _____ R _____	_____
	T _____ R _____	_____
	T _____ R _____	_____
2. Property Controlling in Section	S _____ T _____ R _____	_____
	S _____ T _____ R _____	_____
3. Miscellaneous Property in Sec.	S _____ T _____ R _____	_____
	S _____ T _____ R _____	_____

96 AUG -8 AM 8:47  
 REG. OF DEEDS  
 STATE OF MICHIGAN  
 COUNTY OF KENT  
 RECEIVED FOR RECORD  
 9315  
 Register of Deeds Stamp & File Number

4. Lot No. \_\_\_\_\_, Recorded Plat \_\_\_\_\_  
 5. Private Claims \_\_\_\_\_

I, Randy Kolehouse, in a field survey on January 25 19 96, do hereby certify that under requirements of P.A. 74 Michigan P.A. of 1970, the corner points mentioned in lines 1 and 2 above were in conformance with regulations and rules therefore as required in the current manual of survey instructions of the United States Department of the Interior, Bureau of Land Management or by a decree of a Court of Law and/or that the corner points mentioned in lines 3, 4 and 5 above were in conformance with the rules of the Michigan Board of Land Surveyors or by a Decree of a Court of Law; established, re-established, monumented, re-monumented, recovered, found as expressed below:

**NOTE: Not more than 4 corners, all in the same town and range, may be recorded on this certificate.**

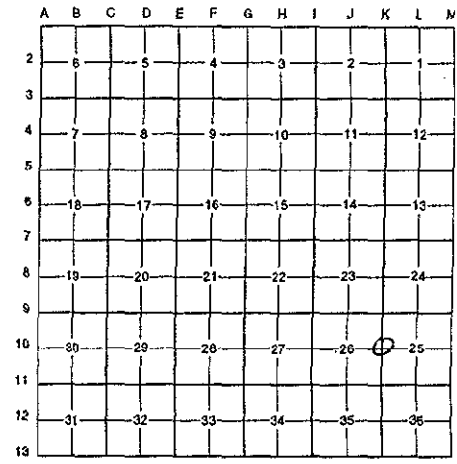

A. Description of original monument and accessories and/or subsequent restoration:

K-10	1831	G.L.O. Notes	Mullett	Set Post
	N/A	Witness Map	K.C. Surveyor	3/4" Iron
	1974	L.C.R.C. #760	Exxel Engineering	1/2" Iron
	1982	L.C.R.C. #2839	Jonker Land Surveys	Fnd. 1/2" Iron in 3/4" Iron / Set K.C. Monument
	1993	L.C.R.C. #7175	Glaza & Associates	K.C. Monument

P.A. 345 1990 KENT COUNTY  
 PEER APPROVED 3/7/96  
 CHAIRMAN Randy Kolehouse

This corner was originally approved by the Kent County Remonumentation Peer Group and monumented by Jonker Land Surveys on 4/20/82 and was recorded per L.C.R.C. #2839.


B. Description of corner evidence found and/or method applied in restoring or reestablishing corner:  
 K-10 Found a Standard Kent County Monument 66.0' West of East Paris (bit.) running North and South on fence line to East per L.C.R.C.'s #2839 and #7175 as set by Jonker Land Surveys in place of 1/2" Iron they found which checked L.C.R.C. #760 and K.C. Surveyor's records.

L.C.R.C. #2839	L.C.R.C. #7175
Remon. tag on N side 36" Maple N 08° W 24.21'	Nail & K.C. remon tag in N side 36" Maple N 85° W 24.12' (m. 23.93') (new)
Remon. tag on E side 18" Maple S 20° W 62.62'	Nail & K.C. remon tag in E side 20" Maple S 20° W 62.35' (m. 63.23') (new)
Remon. tag on S side fe. post N 60° E 38.28'	C/L North-South pavement East 66'
Remon. tag on S side cor. fe. post S 90° E 59.85'	On fence line to the East
	Nail & K.C. remon tag in NW side 12" Triple Ash N 50° E 60.72' (m. 60.69')
	Nail & K.C. remon tag in N side 14" Maple N 90° E 50.23' (m. 50.25')

The selected location is accepted by me and is generally accepted by professional surveyors as the best available evidence of the position of the original corner.

C. Description of monument for corner and accessories established to perpetuate locating the position of the corner:  
 K-10 Standard Kent County Monument

- Nail & K.C. remon tag in N side 36" Maple N 85° W 23.93'
- Nail & K.C. remon tag in E side 20" Maple S 20° W 62.23'
- Nail & K.C. remon tag in NW side 12" Triple Ash N 50° E 60.69'
- Nail & K.C. remon tag in N side 14" Maple N 90° E 50.25'

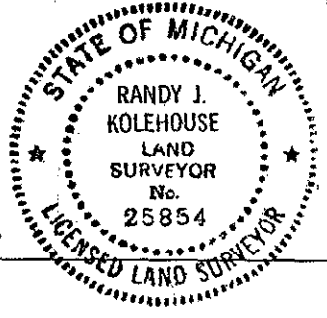

Signed by Randy J. Kolehouse Date 7/23/96  
 EARTH TECH  
 Surveyor's Michigan License No. 25854