

**SURVEY & REMONUMENTATION**

FEB 14 1997

COMMISSION

**LAND CORNER RECORDATION CERTIFICATE**  
**Filing Requirement of Act 74, Mich. P.A. 1970**  
**KENT COUNTY REMONUMENTATION**

For corners in

	Kent (County)	Located in: Gaines Township	Corner Code #
1. Public Land Survey		T <u>5N</u> R <u>11W</u>	<u>K-11</u>
		T _____ R _____	_____
		T _____ R _____	_____
		T _____ R _____	_____
2. Property Controlling in Section	S _____	T _____ R _____	_____
	S _____	T _____ R _____	_____
3. Miscellaneous Property in Sec.	S _____	T _____ R _____	_____
	S _____	T _____ R _____	_____
4. Lot No. _____, Recorded Plat _____			
5. Private Claims _____			

STATE OF MICHIGAN  
 COUNTY OF KENT  
 RECEIVED FOR RECORD


96 AUG -8 AM 8:47

REG. OF DEEDS  
*David Stoddard*

**9316**

Register of Deeds Stamp & File Number

I, Randy Kolehouse, in a field survey on January 3 19 96, do hereby certify that under requirements of P.A. 74 Michigan P.A. of 1970, the corner points mentioned in lines 1 and 2 above were in conformance with regulations and rules therefore as required in the current manual of survey instructions of the United States Department of the interior, Bureau of Land Management or by a decree of a Court of Law and/or that the corner points mentioned in lines 3, 4 and 5 above were in conformance with the rules of the Michigan Board of Land Surveyors or by a Decree of a Court of Law; established, re-established, monumented, re-monumented, recovered, found as expressed below:

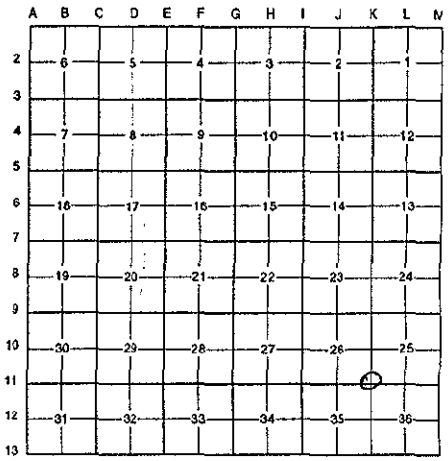

**NOTE: Not more than 4 corners, all in the same town and range, may be recorded on this certificate.**

**A. Description of original monument and accessories and/or subsequent restoration:**

K-11	1831	G.L.O. Notes	Mullett	Set Post
	1952	Witness Map	K.C. Surveyor	Monument Box
	1976	L.C.R.C. #958	McPherson	3/4" Iron in Monument Box
	1982	L.C.R.C. #2840	Jonker Land Surveys	Fnd. 3/4" Iron in Mon. Box / Set K.C. Monument
	1994	L.C.R.C. #7199	Glaza & Associates	K.C. Monument

P.A. 345 1990 KENT COUNTY  
 PEER APPROVED 3/2/96  
 CHAIRMAN *Randy Huber*

This corner was originally approved by the Kent County Remonumentation Peer Group and monumented by Rob Jonker on 4/15/82 and was recorded per L.C.R.C. #2840.

**B. Description of corner evidence found and/or method applied in restoring or reestablishing corner:**

K-11 Found a Standard Kent County Monument at the C/L intersection of 100th Street (bit.) running East and West and East Paris Avenue (bit.) running North and South per L.C.R.C.'s #958, #2840 and #7199 as set by Rob Jonker in place of a 3/4" iron in a monument box he found that checked L.C.R.C. #958 and K.C. Surveyor's records.

L.C.R.C. #2840	L.C.R.C. #7199
P.K. nail on C/L top concrete R.O.W. marker S 65° W 60.65' SW corner school fnd. N 40° E 109.2'	P.K. nail on C/L top concrete R.O.W. marker S 65° W 60.65' SW corner school foundation N 40° E 109.20'

The selected location is accepted by me and is generally accepted by professional surveyors as the best available evidence of the position of the original corner.

**C. Description of monument for corner and accessories established to perpetuate locating the position of the corner:**

K-11 Standard Kent County Monument

- SW cor. brick Bldg. at NE cor. int. N 43° E 109.39'
- SE cor. brick bldg. at NE cor. int. N 51° E 125.72' (4' above grade)
- Nail & K.C. remon. tag on W side P. pole at NW cor. int. N 28° W 58.10'
- Nail & K.C. remon. tag on top fence post - most E'ly post S 45° E 58.10'



Signed by *Randy J. Kolehouse*  
 EARTH TECH

Date 7/23/96

Surveyor's Michigan License No. 25854