

FEB 14 1997

COMMISSION

LAND CORNER RECORDATION CERTIFICATE
Filing Requirement of Act 74, Mich. P.A. 1970
KENT COUNTY REMONUMENTATION

For corners in

Table with columns: Kent (County), Located in: Gaines Township, Corner Code #. Rows include Public Land Survey, Property Controlling in Section, and Miscellaneous Property in Sec.

STATE OF MICHIGAN
COUNTY OF KENT
RECEIVED FOR RECORD
96 AUG -8 AM 8:47
REG. OF DEEDS
9317
Register of Deeds Stamp & File Number

4. Lot No. _____, Recorded Plat _____
5. Private Claims _____


I, Randy Kolehouse, in a field survey on January 26, 1996, do hereby certify that under requirements of P.A. 74 Michigan P.A. of 1970, the corner points mentioned in lines 1 and 2 above were in conformance with regulations and rules therefore as required in the current manual of survey instructions of the United States Department of the interior, Bureau of Land Management or by a decree of a Court of Law and/or that the corner points mentioned in lines 3, 4 and 5 above were in conformance with the rules of the Michigan Board of Land Surveyors or by a Decree of a Court of Law; established, re-established, monumented, re-monumented, recovered, found as expressed below:

NOTE: Not more than 4 corners, all in the same town and range, may be recorded on this certificate.

A. Description of original monument and accessories and/or subsequent restoration:

Table with columns: K-12, 1831, G.L.O. Notes, Mullett, Set Post, 1961, Witness Map, K.C. Surveyor, Iron, 1976, L.C.R.C. #958, McPherson, 3/4" Iron, 1983, L.C.R.C. #3585, J. Bueche, Found 3/4" Iron - Set K.C. Monument, 1993, L.C.R.C. #7174, Glaza & Associates, K.C. Monument

P.A. 345 1990 KENT COUNTY
PEER APPROVED 3/7/96
CHAIRMAN Randy Hubert

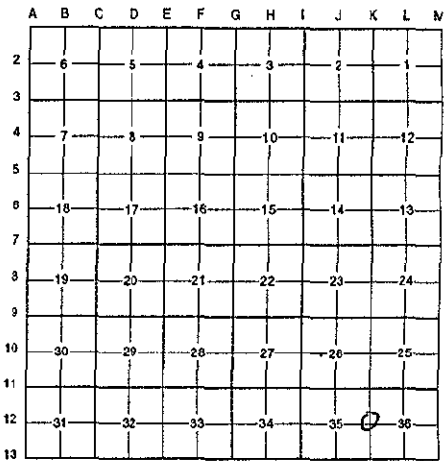

This corner was originally approved by the Kent County Remonumentation Peer Group and monumented by J. Bueche on 10/4/83 and was recorded per L.C.R.C. #3585.

B. Description of corner evidence found and/or method applied in restoring or reestablishing corner:

K-12 Found a Standard Kent County Monument on the C/L of East Paris Avenue (bit.) running North and South and on line of a fence running West and East per L.C.R.C.'s #3585 and #7174 as set by J. Bueche in place of an iron he found which checked L.C.R.C. #958 and K.C. Surveyor's records.

L.C.R.C. #3585

L.C.R.C. #7174

K.C. Remon. tag & nail in S. power pole N 85° W 45.27'
K.C. Remon. tag & nail in E. side 18" Maple S 20° W 76.62' (stump)
Iron fence post W. 21.6'
on fence line West
field division East
on C/L blacktop road N & S

K.C. remon tag & nail in S. P. pole N 85° W 45.27' (m. 45.16')
On fence line West
On fence line East
On C/L blacktop road N & S
K.C. remon tag & nail in East side P. pole N 05° W 301.11' (m. 301.02')
K.C. remon tag & nail in East side P. pole S 08° W 332.92' (m. 332.88')

The selected location is accepted by me and is generally accepted by professional surveyors as the best available evidence of the position of the original corner.

C. Description of monument for corner and accessories established to perpetuate locating the position of the corner:

K-12 Standard Kent County Monument

- Nail & K.C. remon. tag on S side fence post N 90° E 31.71'
Nail & K.C. remon. tag on E side P. pole S 08° W 332.88'
Nail & K.C. remon. tag on S side P. pole N 85° W 45.16'
Nail & K.C. remon. tag on E side P. pole N 05° W 301.02'

Signed by Randy J. Kolehouse
EARTH TECH

Date 7/23/96

Surveyor's Michigan License No. 25854

