

JAN 23 1996

\$70
\$20

COMMISSION

LAND CORNER RECORDATION CERTIFICATE
Filing Requirement of Act 74, Mich. P.A. 1970
KENT COUNTY REMONUMENTATION

For corners in


Kent (County)	Located in:	Corner Code #
1. Public Land Survey	T 5N R 11W	L-2
	T R	
	T R	
	T R	
2. Property Controlling in Section	S T R	
	S T R	
3. Miscellaneous Property in Sec.	S T R	
	S T R	

STATE OF MICHIGAN
COUNTY OF KENT
RECEIVED FOR RECORD
95 DEC 28 PM 2:22
REG. OF DEEDS
Lucy Spauld

8920
Register of Deeds Stamp & File Number

- 4. Lot No. _____, Recorded Plat _____
- 5. Private Claims _____

I, Randy Kolehouse, in a field survey on May 13 19 95, do hereby certify that under requirements of P.A. 74 Michigan P.A. of 1970, the corner points mentioned in lines 1 and 2 above were in conformance with regulations and rules therefore as required in the current manual of survey instructions of the United States Department of the interior, Bureau of Land Management or by a decree of a Court of Law and/or that the corner points mentioned in lines 3, 4 and 5 above were in conformance with the rules of the Michigan Board of Land Surveyors or by a Decree of a Court of Law; established, re-established, monumented, re-monumented, recovered, found as expressed below:

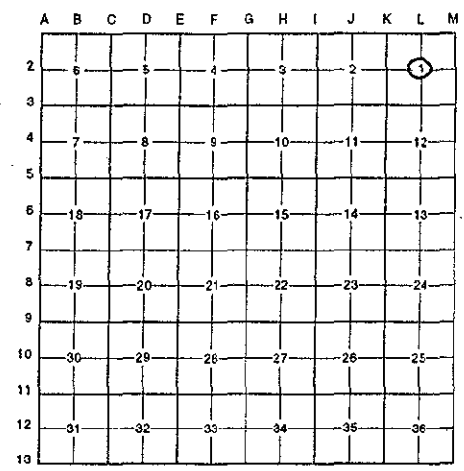

NOTE: Not more than 4 corners, all in the same town and range, may be recorded on this certificate.

A. Description of original monument and accessories and/or subsequent restoration:

L-2 This corner was not originally set by the G.L.O.
 1975 L.C.R.C. #88 Exxel Engineering Set 3/4" Iron at Intersection of 1/4 Lines

P.A. 345 1990 KENT COUNTY
 PEER APPROVED 10/26/95
 CHAIRMAN *Harry Huber*

Note: No record of this corner in K.C. Surveyor's records on K.C. Witness Map.

B. Description of corner evidence found and/or method applied in restoring or reestablishing corner:

L-2 Found 3/4" iron as set by Exxel Engineering in 1975 at the intersection of 1/4 lines. 3/4" iron checks L.C.R.C. #898 as is within 0.10' of the intersection of 1/4 lines. Accepted 3/4" iron as Center Section.


L.C.R.C. #898

- Nail in sde 18" Beech WNW 44.79'
- Nail in sde 10" Ash SW 24.54'
- Nail in sde 10" Ash SE 37.63'

C. Description of monument for corner and accessories established to perpetuate locating the position of the corner:

L-2 Replaced 3/4" iron with a Standard 4" x 30" Kent County Monument.

- Nail & K.C. remon. tag in S face 20" Beech N 70° W 44.79' (over old nail)
- Nail & K.C. remon. tag in W face 14" Ash S 30° W 24.52'
- Nail & K.C. remon. tag in S face 4" Hickory S 80° E 21.33'
- Nail & K.C. remon. tag in E side 10" Ash S 35° E 37.63'

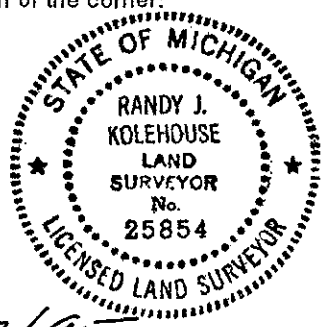

Signed by *Randy J. Kolehouse* Date 12/20/95
 EARTH TECH

Surveyor's Michigan License No. 25854