

JAN 23 1996

COMMISSION

LAND CORNER RECORDATION CERTIFICATE
Filing Requirement of Act 74, Mich. P.A. 1970
KENT COUNTY REMONUMENTATION

For corners in

Kent
(County)

Located in:

Corner Code #

1. Public Land Survey	T	5N	R	11W	L-4
	T		R		
	T		R		
	T		R		
2. Property Controlling in Section	S		T		
	S		T		
3. Miscellaneous Property in Sec.	S		T		
	S		T		

STATE OF MICHIGAN
COUNTY OF KENT
RECEIVED FOR RECORD

95 DEC 28 PM 2:22


REG. OF DEEDS

Lucy Bond

8921

Register of Deeds Stamp & File Number

4. Lot No. _____, Recorded Plat _____
5. Private Claims _____

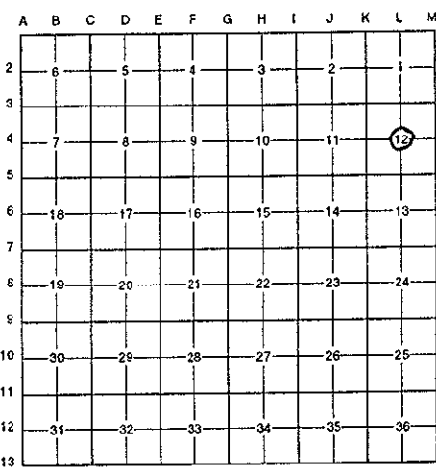

I, Randy Kolehouse, in a field survey on May 19 19 95, do hereby certify that under requirements of P.A. 74 Michigan P.A. of 1970, the corner points mentioned in lines 1 and 2 above were in conformance with regulations and rules therefore as required in the current manual of survey instructions of the United States Department of the interior, Bureau of Land Management or by a decree of a Court of Law and/or that the corner points mentioned in lines 3, 4 and 5 above were in conformance with the rules of the Michigan Board of Land Surveyors or by a Decree of a Court of Law; established, re-established, monumented, re-monumented, recovered, found as expressed below:

NOTE: Not more than 4 corners, all in the same town and range, may be recorded on this certificate.

A. Description of original monument and accessories and/or subsequent restoration:
L-4 This corner was not originally set by the G.L.O.
1989 Survey Records Exxel Engineering Set Iron at Intersection of 1/4 Lines

P.A. 345 1990 KENT COUNTY
PEER APPROVED 10/26/95
CHAIRMAN *Randy Kolehouse*

No record of corner in K.C. Surveyor's records.

B. Description of corner evidence found and/or method applied in restoring or reestablishing corner:
L-4 Found a capped Exxel iron which checked witnesses from Exxel Engineering survey records. This iron is within 0.1' of the intersection of 1/4 lines. Accepted iron as Center Section.

Exxel Witness
Nail SE side 16" Hickory NE 9.87'
Nail E side 14" Hickory S 27.11'

C. Description of monument for corner and accessories established to perpetuate locating the position of the corner:
L-4 Replaced capped Exxel iron with Standard 4" x 30" Kent County Monument.
Nail & K.C. remon. tag in NW face Double 10" Ash S 75° W 16.90'
Nail & K.C. remon. tag in NE face 12" Ash S 15° W 17.13'
Nail & K.C. remon. tag in N face 16" Hickory S 80° E 17.89'
Nail & K.C. remon. tag in SE face 16" Maple N 45° E 9.92'



Signed by *Randy J. Kolehouse* Date 12/22/95
EARTH TECH

Surveyor's Michigan License No. 25854