

SURVEY & REMONUMENTATION

FEB 14 1997

COMMISSION

LAND CORNER RECORDATION CERTIFICATE
Filing Requirement of Act 74, Mich. P.A. 1970
KENT COUNTY REMONUMENTATION

For corners in

Kent (County)	Located in:	Gaines Township	Corner Code #
1 Public Land Survey	T <u>5N</u>	R <u>11W</u>	<u>L-7</u>
	T _____	R _____	_____
	T _____	R _____	_____
	T _____	R _____	_____
2 Property Controlling in Section	S _____	T _____	R _____
	S _____	T _____	R _____
3 Miscellaneous Property in Sec.	S _____	T _____	R _____
	S _____	T _____	R _____
4 Lot No. _____, Recorded Plat _____			
5 Private Claims _____			

STATE OF MICHIGAN
 COUNTY OF KENT
 RECEIVED FOR RECORD
 95 AUG -8 AM 8:47
 REG. OF DEEDS
 9322

Register of Deeds Stamp & File Number

I, Randy Kolehouse, in a field survey on January 5 19 96, do hereby certify that under requirements of P.A. 74 Michigan P.A. of 1970, the corner points mentioned in lines 1 and 2 above were in conformance with regulations and rules therefore as required in the current manual of survey instructions of the United States Department of the interior, Bureau of Land Management or by a decree of a Court of Law and/or that the corner points mentioned in lines 3, 4 and 5 above were in conformance with the rules of the Michigan Board of Land Surveyors or by a Decree of a Court of Law; established, re-established, monumented, re-monumented, recovered, found as expressed below:

	A	B	C	D	E	F	G	H	I	J	K	L	M
2	6	5	4	3	2	1							
3													
4	7	8	9	10	11	12							
5													
6	18	17	16	15	14	13							
7													
8	19	20	21	22	23	24							
9													
10	30	29	28	27	26	25							
11													
12	01	02	03	04	05	06							
13													

NOTE: Not more than 4 corners, all in the same town and range, may be recorded on this certificate.

A. Description of original monument and accessories and/or subsequent restoration:

L-7	1831	G.L.O. Notes	Mulleit	Set Post
	1959	Witness Map	K.C. Surveyor	Monument Box
	1972	L.C.R.C. #3259	C. Hay	1" Iron in Mon Box
	1983	L.C.R.C. #3583	J. Bueche	Fnd. 3/4" Iron / Set K.C. Monument
	1994	L.C.R.C. #7179	Glaza & Associates	K.C. Monument

P.A. 345 1990 KENT COUNTY
 PEER APPROVED 3/2/99
 CHAIRMAN Randy Kolehouse

This corner was originally approved by the Kent County Remonumentation Peer Group and monumented by J. Bueche on 11/2/83 and was recorded per L.C.R.C. #3583.

B. Description of corner evidence found and/or method applied in restoring or reestablishing corner:


L-7 Found a Standard Kent County Monument 2.5' North of the C/L of 84th Street running East & West on line of fence running to the South per L.C.R.C.'s #3583 and #7179 as set by J. Bueche in place of a 3/4" iron over another 3/4" iron in a monument box he found that checked L.C.R.C. #3259 and K.C. Surveyor's records.

L.C.R.C. #3583	L.C.R.C. #7179
K.C. Remon. tag & nail in N. side 60" Poplar N 80° E 154.54'	K.C. remon tag & nail in N side 60" Oak N 80° E 154.54' (m. 154.45')

The selected location is accepted by me and is generally accepted by professional surveyors as the best available evidence of the position of the original corner.

C. Description of monument for corner and accessories established to perpetuate locating the position of the corner:

- L-7 Standard Kent County Monument
- Nail & K.C. remon. tag on most W'y fence post S 02° NE 29.11'
 - Nail & K.C. remon. tag on wood fence post (6th post) to the East S 50° W 54.09'
 - Nail & K.C. remon. tag on W side P. pole S 05° E 115.62'
 - Nail & K.C. remon. tag on N side 60" Oak N 80° E 154.45'

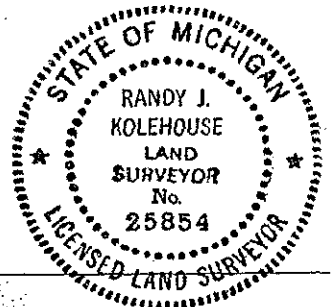

Signed by Randy J. Kolehouse Date 7/23/96
 EARTH TECH

Surveyor's Michigan License No. 25854