

\$7.00
\$2.00

Survey &
MONUMENTATION

JAN 23 1996

LAND CORNER RECORDATION CERTIFICATE
Filing Requirement of Act 74, Mich. P.A. 1970
KENT COUNTY REMONUMENTATION

For corners in

COMMISSION

Kent (County)	Located in:	Corner Code #
1. Public Land Survey	T <u>5N</u> R <u>11W</u>	<u>L-8</u>
	T _____ R _____	_____
	T _____ R _____	_____
	T _____ R _____	_____
2. Property Controlling in Section	S _____ T _____ R _____	_____
	S _____ T _____ R _____	_____
3. Miscellaneous Property in Sec.	S _____ T _____ R _____	_____
	S _____ T _____ R _____	_____


STATE OF MICHIGAN
COUNTY OF KENT
RECEIVED FOR RECORD

95 DEC 28 PM 2:22

REG. OF DEEDS
Lucy Bond
8023

Register of Deeds Stamp & File Number

- 4. Lot No. _____, Recorded Plat _____
- 5. Private Claims _____

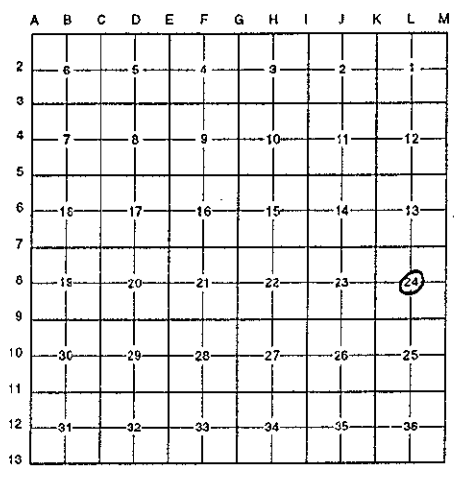

I, Randy Kolehouse, in a field survey on October 6 19 95, do hereby certify that under requirements of P.A. 74 Michigan P.A. of 1970, the corner points mentioned in lines 1 and 2 above were in conformance with regulations and rules therefore as required in the current manual of survey instructions of the United States Department of the Interior, Bureau of Land Management or by a decree of a Court of Law and/or that the corner points mentioned in lines 3, 4 and 5 above were in conformance with the rules of the Michigan Board of Land Surveyors or by a Decree of a Court of Law; established, re-established, monumented, re-monumented, recovered, found as expressed below:

NOTE: Not more than 4 corners, all in the same town and range, may be recorded on this certificate.


- A. Description of original monument and accessories and/or subsequent restoration:
L-8 This corner was not originally set by the G.L.O.
?? Survey Records Exxel Engineering Used Calc. Center
No other information on record.

P.A. 345 1990 KENT COUNTY
PEER APPROVED 10/26/95
CHAIRMAN Harry Hubert

- B. Description of corner evidence found and/or method applied in restoring or reestablishing corner:
L-8 Set a Kent County Monument at the intersection of 1/4 lines which position checks within 0.2' of calculated position per Exxel Engineering survey notes.

- C. Description of monument for corner and accessories established to perpetuate locating the position of the corner:
L-8 Set a Standard 4" x 30" Kent County Monument.

- Nail & K.C. remon. tag in S side 8" wood fence post S 62° E 8.75'
- Nail & K.C. remon. tag in SE side 3' Maple N 30° E 17.36'
- Nail & K.C. remon. tag in N side 8" wood fence post S 81° W 23.62'
- Nail & K.C. remon. tag in NW side 10" Maple S 63° W 145.22'

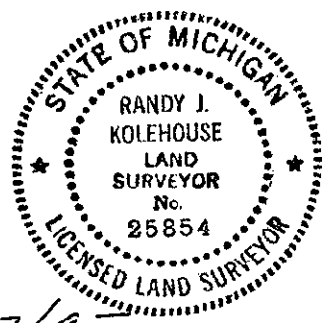

Signed by Randy J. Kolehouse Date 12/22/95
EARTH TECH

Surveyor's Michigan License No. 25854