

FEB 14 1997

COMMISSION

LAND CORNER RECORDATION CERTIFICATE
Filing Requirement of Act 74, Mich. P.A. 1970
KENT COUNTY REMONUMENTATION

For corners in

Kent (County)	Located in:	Gaines Township	Corner Code #
1. Public Land Survey	T <u>5N</u>	R <u>11W</u>	<u>L-9</u>
	T _____	R _____	_____
	T _____	R _____	_____
	T _____	R _____	_____
2. Property Controlling in Section	S _____	T _____	R _____
	S _____	T _____	R _____
3. Miscellaneous Property in Sec.	S _____	T _____	R _____
	S _____	T _____	R _____

REG. OF DEEDS

9323

Register of Deeds Stamp & File Number

96 AUG -8 AM 8:47

STATE OF MICHIGAN
COUNTY OF KENT
RECEIVED FOR RECORD

4. Lot No. _____, Recorded Plat _____
5. Private Claims _____

I, Randy Kolehouse, in a field survey on January 5 19 96, do hereby certify that under requirements of P.A. 74 Michigan P.A. of 1970, the corner points mentioned in lines 1 and 2 above were in conformance with regulations and rules therefore as required in the current manual of survey instructions of the United States Department of the interior, Bureau of Land Management or by a decree of a Court of Law and/or that the corner points mentioned in lines 3, 4 and 5 above were in conformance with the rules of the Michigan Board of Land Surveyors or by a Decree of a Court of Law; established, re-established, monumented, re-monumented, recovered, found as expressed below:

NOTE: Not more than 4 corners, all in the same town and range, may be recorded on this certificate.

	A	B	C	D	E	F	G	H	I	J	K	L	M
2	6	5	4	3	2	1							
3													
4	7	8	9	10	11	12							
5													
6	15	17	16	15	14	13							
7													
8	19	20	21	22	23	24							
9													
10	30	28	28	27	26	25							
11													
12	31	32	33	34	35	36							
13													

A. Description of original monument and accessories and/or subsequent restoration:

L-9	1831	G.L.O. Notes	Mullett	Set Post	P.A. 345 1990 KENT COUNTY PEER APPROVED <u>03/17/96</u> CHAIRMAN <u>Randy Kolehouse</u>
	N/A	Witness Map	K.C. Surveyor	Stake	
	1946	Survey Records	Williams & Works	Cut in Pavement	
	1976	L.C.R.C. #969	Ankrom	Set Rebar	
	1983	L.C.R.C. #43739	William Byl	Found Rebar / Set K.C. Monument	
	1994	L.C.R.C. #7200	Glaza & Associates	K.C. Monument	

This corner was originally approved by the Kent County Remonumentation Peer Group and monumented by William Byl on 9/29/83 and was recorded per L.C.R.C. #3739.

B. Description of corner evidence found and/or method applied in restoring or reestablishing corner:

L-9 Found a Standard Kent County Monument on the C/L of 92nd Street (bit.) per L.C.R.C.'s #3969, #3739 and #7200 as set by William Byl in place of a rebar he found that was set by Consumers Power Company survey at the midpoint of Section line, this point per William Byl is within 0.4' of location of "+" in pavement per Williams & Works survey records ("+" not recovered).

L.C.R.C. #3739

"v" cut in SW leg of C.P.CO. powerline tower N 05 E 129.10'
Nail & tag, E. sd. power pole S 35 W 113.08'
Nail & tag, S. sd. power pole S 65 W 91.92'

L.C.R.C. #7200

"v" cut in SW leg of C.P.CO. powerline tower N 05 E 129.10' (m. 129.05')
Nail & K.C. remon tag in E. side P. pole S 35 W 113.08'
Nail & K.C. remon tag in S. side P. pole S 65 W 91.92' (m. 91.88')

The selected location is accepted by me and is generally accepted by professional surveyors as the best available evidence of the position of the original corner.


C. Description of monument for corner and accessories established to perpetuate locating the position of the corner:

L-9 Standard Kent County Monument

Nail & K.C. remon. tag on NW side high voltage P. pole S 50° W 123.16'
Nail & K.C. remon. tag on E side P. pole S 35 W 113.08'
Nail & K.C. remon. tag on S. side P. pole S 65 W 91.88'
"v" cut in SW leg of C.P.CO. powerline tower N 05 E 129.05'

Signed by Randy J. Kolehouse
EARTH TECH

Date 7/23/96

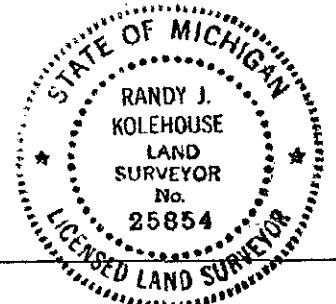

Surveyor's Michigan License No. 25854