

JAN 23 1996

COMMISSION LAND CORNER RECORDATION CERTIFICATE
Filing Requirement of Act 74, Mich. P.A. 1970
KENT COUNTY REMONUMENTATION

For corners in

Kent (County)	Located in:	Corner Code #
1. Public Land Survey	T <u>5N</u> R <u>11W</u>	<u>L-10</u>
	T _____ R _____	_____
	T _____ R _____	_____
	T _____ R _____	_____
2. Property Controlling in Section	S _____ T _____ R _____	_____
	S _____ T _____ R _____	_____
3. Miscellaneous Property in Sec.	S _____ T _____ R _____	_____
	S _____ T _____ R _____	_____

STATE OF MICHIGAN
COUNTY OF KENT
RECEIVED FOR RECORD

95 DEC 28 PM 2:22

REG. OF DEEDS
Eric S. [Signature]
8824

Register of Deeds Stamp & File Number

4. Lot No. _____, Recorded Plat _____

5. Private Claims _____

	A	B	C	D	E	F	G	H	I	J	K	L	M
2	6		5		4		3		2		1		
3													
4	7		6		5		4		3		2		1
5													
6	18		17		16		15		14		13		
7													
8	19		20		21		22		23		24		
9													
10	30		29		28		27		26		25		
11													
12	31		32		33		34		35		36		
13													

I, Randy Kolehouse, in a field survey on November 10 19 95, do hereby certify that under requirements of P.A. 74 Michigan P.A. of 1970, the corner points mentioned in lines 1 and 2 above were in conformance with regulations and rules therefore as required in the current manual of survey instructions of the United States Department of the Interior, Bureau of Land Management or by a decree of a Court of Law and/or that the corner points mentioned in lines 3, 4 and 5 above were in conformance with the rules of the Michigan Board of Land Surveyors or by a Decree of a Court of Law; established, re-established, monumented, re-monumented, recovered, found as expressed below:

NOTE: Not more than 4 corners, all in the same town and range, may be recorded on this certificate.

A. Description of original monument and accessories and/or subsequent restoration:

L-10 This corner was not originally set by the G.L.O.

No recorded information was found.

P.A. 345 1990 KENT COUNTY
PEER APPROVED 10/26/95
CHAIRMAN *[Signature]*


B. Description of corner evidence found and/or method applied in restoring or reestablishing corner:

L-10 Set K.C. Monument at intersection of 1/4 lines at jog in woods running North and South and 90° ± Westerly of C/L of power lines.

C. Description of monument for corner and accessories established to perpetuate locating the position of the corner:

L-10 Set a Standard 4" x 30" Kent County Monument.

Nail & K.C. remon. tag in E side 14" Maple N 12° W 75.07'
Nail & K.C. remon. tag in N side P. pole W'y of Pair N 82° E 80.14'
Nail & K.C. remon. tag in NE side 10" Oak S 45° E 14.71'
Nail & K.C. remon. tag in NW side 14" Sycamore N 58° W 36.77'
Nail & K.C. remon. tag in SW side 28" Beech N 61° W

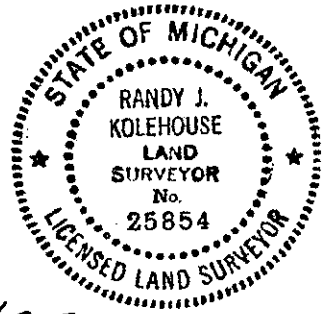

Signed by Randy J. Kolehouse Date 12/22/95
EARTH TECH
Surveyor's Michigan License No. 25854