

JAN 23 1996

LAND CORNER RECORDATION CERTIFICATE
Filing Requirement of Act 74, Mich. P.A. 1970
KENT COUNTY REMONUMENTATION

For corners in **COMMISSION**

Kent (County)	Located in:	Corner Code #
1. Public Land Survey	T <u>5N</u> R <u>11W</u>	<u>L-12</u>
	T _____ R _____	_____
	T _____ R _____	_____
	T _____ R _____	_____
2. Property Controlling in Section	S _____ T _____ R _____	_____
	S _____ T _____ R _____	_____
3. Miscellaneous Property in Sec.	S _____ T _____ R _____	_____
	S _____ T _____ R _____	_____

STATE OF MICHIGAN
COUNTY OF KENT
RECEIVED FOR RECORD

95 DEC 28 PM 2:22

REG. OF DEEDS
Randy J. Kolehose
8935

Register of Deeds Stamp & File Number

- 4. Lot No. _____, Recorded Plat _____
- 5. Private Claims _____

	A	B	C	D	E	F	G	H	I	J	K	L	M
2	6		5		4		3		2		1		
3													
4	7		8		9		10		11		12		
5													
6	13		17		16		15		14		13		
7													
8	19		20		21		22		23		24		
9													
10	30		29		28		27		26		25		
11													
12	31		32		33		34		35		35		
13													

I, Randy Kolehose, in a field survey on May 17 19 95, do hereby certify that under requirements of P.A. 74 Michigan P.A. of 1970, the corner points mentioned in lines 1 and 2 above were in conformance with regulations and rules therefore as required in the current manual of survey instructions of the United States Department of the Interior, Bureau of Land Management or by a decree of a Court of Law and/or that the corner points mentioned in lines 3, 4 and 5 above were in conformance with the rules of the Michigan Board of Land Surveyors or by a Decree of a Court of Law; established, re-established, monumented, re-monumented, recovered, found as expressed below:

NOTE: Not more than 4 corners, all in the same town and range, may be recorded on this certificate.

A. Description of original monument and accessories and/or subsequent restoration:

L-12 This corner was not originally set by the G.L.O.

1980 L.C.R.C. #1353 Exxel Engineering Set Capped Iron at Int. of 1/4 Lines

P.A. 345 1990 KENT COUNTY
PEER APPROVED 10/26/95
CHAIRMAN Randy Kolehose

B. Description of corner evidence found and/or method applied in restoring or reestablishing corner:

L-12 Found rebar per L.C.R.C. #1353 at the intersection of 1/4 lines at fence line running West and running South as set by Exxel Engineering. Accepted rebar as Center Section.


L.C.R.C. #1353

PK in sde 14" Ash SW 30.81'
PK in sde P. Pole NE 114.37'

C. Description of monument for corner and accessories established to perpetuate locating the position of the corner:

L-12 Replaced rebar with a Standrad 4" x 30" Kent County Monument.

PK in SE face P. pole N 40° E 114.37'
Found grown over PK in N face 14" Ash S 60° W 30.81'
Reset nail & K.C. remon. tag in over PK in above tree N 30.73'
Set nail & K.C. remon. tag in S face 10" Ash due West 21.32'
Set nail & K.C. remon. tag in E face 10" Maple S 20° W 57.73'

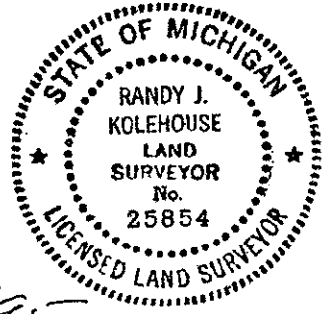

Signed by Randy J. Kolehose Date 12/22/95
EARTH TECH

Surveyor's Michigan License No. 25854