

FEB 14 1997

COMMISSION

LAND CORNER RECORDATION CERTIFICATE
Filing Requirement of Act 74, Mich. P.A. 1970
KENT COUNTY REMONUMENTATION

For corners in


Table with columns: Kent (County), Located in: Gains Township, Corner Code #. Rows include Public Land Survey, Property Controlling in Section, and Miscellaneous Property in Sec.

STATE OF MICHIGAN
COUNTY OF KENT
RECEIVED FOR RECORD
96 AUG - 8 AM 8:47
REG. OF DEEDS

9325

Register of Deeds Stamp & File Number

- 4. Lot No.
5. Private Claims

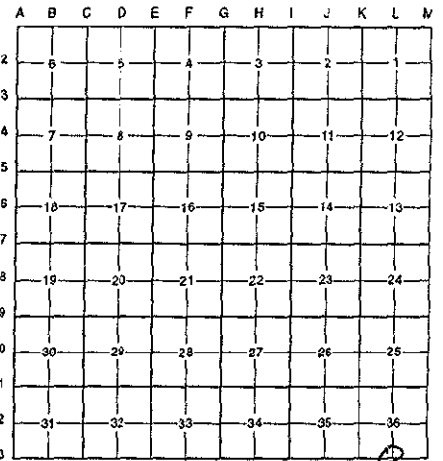

I, Randy Kolehouse, in a field survey on January 18, 1996, do hereby certify that under requirements of P.A. 74 Michigan P.A. of 1970, the corner points mentioned in lines 1 and 2 above were in conformance with regulations and rules therefore as required in the current manual of survey instructions of the United States Department of the interior, Bureau of Land Management or by a decree of a Court of Law and/or that the corner points mentioned in lines 3, 4 and 5 above were in conformance with the rules of the Michigan Board of Land Surveyors or by a Decree of a Court of Law; established, re-established, monumented, re-monumented, recovered, found as expressed below:

NOTE: Not more than 4 corners, all in the same town and range, may be recorded on this certificate.

A. Description of original monument and accessories and/or subsequent restoration:

Table with 4 columns: L-13, Date, Description, Monument Type. Includes entries for 1817, 1977, 1986, and 1994.

Note: This corner is not common with L-1, T4N, R11W.

This corner was originally approved by the Kent County Remonumentation Peer Group and monumented by Jonker Land Surveys on 3/31/86 and was recorded per L.C.R.C. #4425.

P.A. 345 1990 KENT COUNTY
PEER APPROVED 3/17/96
CHAIRMAN Randy Kolehouse

B. Description of corner evidence found and/or method applied in restoring or reestablishing corner:

L-13 Found a Standard Kent County Monument 9.0' South of the C/L of 108th Street (gravel) running East and West as set by Rob Jonker in place of a capped iron they found which checked L.C.R.C. #1083.

L.C.R.C. #4425

L.C.R.C. #7178

- Remon. tag on S.W. side 12" Ash N 45° W 55.25'
Remon. tag on S. side 30" Oak S 80° W 40.00'
C/L hole on S. face of S.W. leg to steel
C.P. Co. tower (2' up) N 40° E 247.7'
Remon tag on E. side p. pole S 00° 32.75'
Capped iron East
C/L E-W gravel North 9' ±

- K.C. remon tag & nail in SW side 18" Ash N 45° W 55.26' (m. 55.17')
K.C. remon tag & nail in S side 30" Oak S 80° W 40.00'
C/L hole on South face of SW leg to steel C.P. Co. tower (2' up) N 40° E 247.70' (m. 247.66')
K.C. remon tag & nail in E side P. pole S 00° W 32.75' (m. 32.62')
Capped Iron East 5.93'
C/L East-West gravel North 9' ±

The selected location is accepted by me and is generally accepted by professional surveyors as the best available evidence of the position of the original corner.

C. Description of monument for corner and accessories established to perpetuate locating the position of the corner:

L-13 Standard Kent County Monument

- Nail & K.C. remon. tag on E side 14" Willow N 00° E 144.94'
Nail & K.C. remon. tag on SW side 18" Ash N 45° W 55.17'
Nail & K.C. remon. tag on S side 30" Oak S 80° W 40.00'
Nail & K.C. remon. tag on E side P. pole S 00° W 32.62'
C/L hole on South face of SW leg to steel C.P. Co. tower N 40° E 247.66'
Capped iron East 5.93'

Signed by Randy J. Kolehouse

Date 7/23/96

Surveyor's Michigan License No. 25854

