

FEB 14 1997

LAND CORNER RECORDATION CERTIFICATE
Filing Requirement of Act 74, Mich. P.A. 1970
KENT COUNTY REMONUMENTATION

For corners in

COMMISSION

Kent (County)	Located in: Gaines Township	Corner Code #
1. Public Land Survey	T <u>5N</u> R <u>11W</u>	<u>M-2</u>
	T _____ R _____	_____
	T _____ R _____	_____
	T _____ R _____	_____
2. Property Controlling in Section	S _____ T _____ R _____	_____
	S _____ T _____ R _____	_____
3. Miscellaneous Property in Sec.	S _____ T _____ R _____	_____
	S _____ T _____ R _____	_____

STATE OF MICHIGAN
COUNTY OF KENT
RECEIVED FOR RECORD
96 AUG -8 AM 8:48
REG. OF DEEDS
9327

Register of Deeds Stamp & File Number

4. Lot No. _____, Recorded Plat _____
5. Private Claims _____

I, Randy Kolehouse, in a field survey on January 3 19 96, do hereby certify that under requirements of P.A. 74 Michigan P.A. of 1970, the corner points mentioned in lines 1 and 2 above were in conformance with regulations and rules therefore as required in the current manual of survey instructions of the United States Department of the Interior, Bureau of Land Management or by a decree of a Court of Law and/or that the corner points mentioned in lines 3, 4 and 5 above were in conformance with the rules of the Michigan Board of Land Surveyors or by a Decree of a Court of Law; established, re-established, monumented, re-monumented, recovered, found as expressed below:

A	B	C	D	E	F	G	H	I	J	K	L	N
2	6	5	4	3	2	1						
3												
4	7	8	9	10	11	12						
5												
6	13	17	16	15	14	13						
7												
8	19	20	21	22	23	24						
9												
10	30	29	28	27	26	25						
11												
12	31	32	33	34	35	36						
13												

NOTE: Not more than 4 corners, all in the same town and range, may be recorded on this certificate.

A. Description of original monument and accessories and/or subsequent restoration:

Date	Description	Surveyor	Monument
M-2 1817	G.L.O. Notes	L. Lyon	Set Post
N/A	Witness Map	K.C. Surveyor	Iron
1975	L.C.R.C. #827	Exxel Engineering	1" Iron
1981	L.C.R.C. #2153	Rob Jonker	Fnd. 1" Iron / Set K.C. Monument
1991	L.C.R.C. #5983	William Byl	K.C. Monument
1994	L.C.R.C. #7189	Glaza & Associates	K.C. Monument

P.A. 345 1990 KENT COUNTY
PEER APPROVED 3/17/96
CHAIRMAN [Signature]

Note: This corner is not common with A-2, T5N, R10W.

This corner was originally approved by the Kent County Remonumentation Peer Group and monumented by Rob Jonker on 8/27/81 and was recorded per L.C.R.C. #2153.

B. Description of corner evidence found and/or method applied in restoring or reestablishing corner:

M-2 Found a Standard Kent County Monument 1' East of the C/L of Patterson Avenue (bit.) running North and South 68.73' North of A-2, T5N, R10W, per L.C.R.C.'s #827, #2153, #5983 and #7189 as set by Rob Jonker in place of a 1" iron he found that checked L.C.R.C. #827.


L.C.R.C. #2153	L.C.R.C. #5983	L.C.R.C. #7189
Iron South 68.73'	Kent Co. Mon. (W 1/4 cor. Sec. 6-5-10) S 00° W 68.73'	Kent Co. Mon. (W 1/4 cor. Sec. 6-5-10) S 00° W 68.73'
Remon. tag on NW side 10" Walnut S 30° W 58.19'	New Nail & KC Remon. tag NW side 12" Walnut S 30° W 58.19'	Nail & K.C. remon tag in NW side 12" Walnut S 30° W 58.19' (m. 58.17')
Remon. tag on SW side 6" Walnut N 40° W 35.39'	Set Nail & KC Remon. tag SW side Tw. 8" Walnut N 40° W 35.59'	Nail & K.C. remon tag in SW side 8" Twin Walnut N 40° W 35.59' (m. 35.57')
Remon. tag on SW side p. pole S 30° E 81.89'	Nail & KC Remon. tag SW side P. Pole S 30° E 81.84'	Nail & K.C. remon tag in SW side P. pole S 30° E 81.84' (m. 81.82')

The selected location is accepted by me and is generally accepted by professional surveyors as the best available evidence of the position of the original corner.

C. Description of monument for corner and accessories established to perpetuate locating the position of the corner:

- M-2 Standard Kent County Monument
- Nail & K.C. remon. tag on SW side 8" Twin Walnut N 40° W 35.57'
- Nail & K.C. remon. tag on SW side P. pole S 30° E 81.82'
- Nail & K.C. remon. tag on N side 12" Walnut S 16° W 87.63'
- Nail & K.C. remon. tag on NW side 12" Walnut S 30° W 58.17'
- Monument W 1/4 Section 6, T5N, R10W, S 00° W 68.73'

Signed by Randy J. Kolehouse Date 7/23/96
EARTH TECH

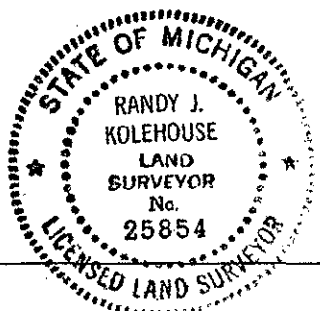

Surveyor's Michigan License No. 25854