

FEB 14 1997

COMMISSION


LAND CORNER RECORDATION CERTIFICATE
Filing Requirement of Act 74, Mich. P.A. 1970
KENT COUNTY REMONUMENTATION

STATE OF MICHIGAN
COUNTY OF KENT
RECEIVED FOR RECORD
96 AUG - 8 AM 8:48

REG. OF DEEDS
9328

Register of Deeds Stamp & File Number

For corners in Kent (County)
Located in: Gaines Township
Corner Code #
1. Public Land Survey T 5N R 11W M-3
2. Property Controlling in Section
3. Miscellaneous Property in Sec.
4. Lot No.
5. Private Claims

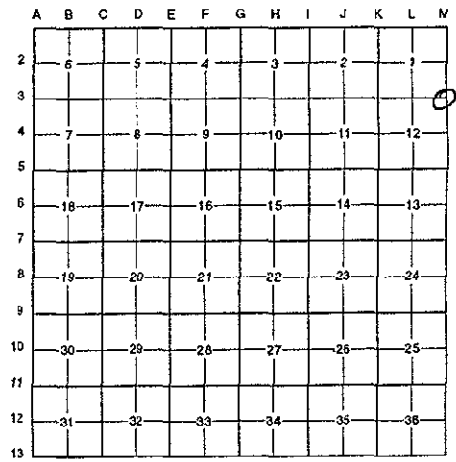

Randy Kolehouse, in a field survey on January 3 19 96, do hereby certify that under requirements of P.A. 74 Michigan P.A. of 1970, the corner points mentioned in lines 1 and 2 above were in conformance with regulations and rules therefore as required in the current manual of survey instructions of the United States Department of the Interior, Bureau of Land Management or by a decree of a Court of Law and/or that the corner points mentioned in lines 3, 4 and 5 above were in conformance with the rules of the Michigan Board of Land Surveyors or by a Decree of a Court of Law; established, re-established, monumented, re-monumented, recovered, found as expressed below:

NOTE: Not more than 4 corners, all in the same town and range, may be recorded on this certificate.

Table with 4 columns: Description of original monument and accessories and/or subsequent restoration, L. Lyon, K.C. Surveyor, Set Post, Iron, Fnd. Iron / Set Bolt, Fnd. 1/2" Iron in Mon. Box / Set K.C. Monument, K.C. Monument, K.C. Monument

P.A. 345 1990 KENT COUNTY
PEER APPROVED 3/2/96
CHAIRMAN Randy Kolehouse

Note: This corner is not common with A-3, T5N, R10W.

This corner was originally approved by the Kent County Remonumentation Peer Group and monumented by Rob Jonker on 9/1/81 and was recorded per L.C.R.C. #2152.


Description of corner evidence found and/or method applied in restoring or reestablishing corner:
M-3 Found a Standard Kent County Monument on C/L of Patterson Avenue (bit.) running North & South 60' M/L North of the C/L of 68th Street (bit.) running East & West and 68.70' North of A-3, T5N, R10W, per L.C.R.C.'s #2152, #5984 and #7163 as set by Rob Jonker in place of a 1/2" iron in a monument box that checked L.C.R.C. #412.

Table with 3 columns: L.C.R.C. #2152, L.C.R.C. #5984, L.C.R.C. #7163. Describes remon. tag on SW side p. pole N 65° W 50.47', Nail & KC Remon. tag SW side P. Pole N 65° W 50.50', Nail & K.C. remon tag in SW side P. pole N 65° W 50.50' (m. 50.54')

The selected location is accepted by me and is generally accepted by professional surveyors as the best available evidence of the position of the original corner.

Description of monument for corner and accessories established to perpetuate locating the position of the corner:
M-3 Standard Kent County Monument

- Nail & K.C. remon. tag on SW side P. pole N 65° W 50.54'
Nail & K.C. remon. tag on SW side 16" Maple N 20° W 66.54'
Nail & K.C. remon. tag on S side P. pole S 72° E 95.58'
Nail & K.C. remon. tag on SW side P. pole S 43° E 137.02'
Nail & K.C. remon. tag on E side 16" Maple S 25° E 135.04'
Nail & K.C. remon. tag on E side P. pole S 15° W 103.02'
K.C. Mon. A-3, T5N, R10W, South 68.70'

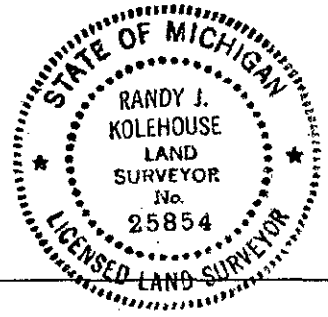

Signed by Randy J. Kolehouse Date 7/23/96

Surveyor's Michigan License No. 25854