

FEB 14 1997

COMMISSION

LAND CORNER RECORDATION CERTIFICATE
Filing Requirement of Act 74, Mich. P.A. 1970
KENT COUNTY REMONUMENTATION


For corners in

Table with columns: Kent (County), Located in: Gains Township, Corner Code #. Rows include Public Land Survey, Property Controlling in Section, and Miscellaneous Property in Sec.

Register of Deeds Stamp & File Number. Includes date 96 AUG -8 AM 8:48, file number 9329, and a signature.

4. Lot No. \_\_\_\_\_, Recorded Plat \_\_\_\_\_
5. Private Claims \_\_\_\_\_

I, Randy Kolehouse, in a field survey on January 3, 1996, do hereby certify that under requirements of P.A. 74 Michigan P.A. of 1970, the corner points mentioned in lines 1 and 2 above were in conformance with regulations and rules therefore as required in the current manual of survey instructions of the United States Department of the interior, Bureau of Land Management or by a decree of a Court of Law and/or that the corner points mentioned in lines 3, 4 and 5 above were in conformance with the rules of the Michigan Board of Land Surveyors or by a Decree of a Court of Law; established, re-established, monumented, re-monumented, recovered, found as expressed below:

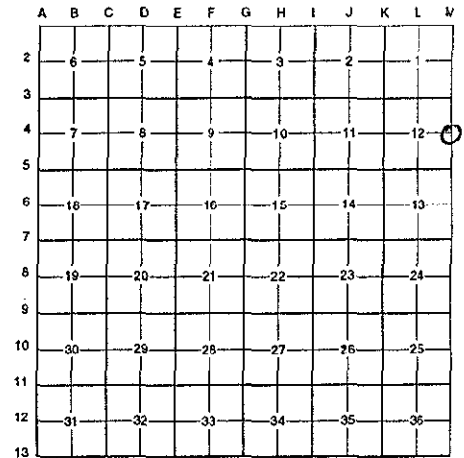

NOTE: Not more than 4 corners, all in the same town and range, may be recorded on this certificate.

A. Description of original monument and accessories and/or subsequent restoration:

Table with 4 columns: M-4, Date (1817, 1964, 1983, 1991, 1993), Description (G.L.O. Notes, Witness Map, L.C.R.C. #3579, #5985, #7191), Name (L. Lyon, K.C. Surveyor, William Byl, Glaza & Associates), and Monument Type (Set Post, Monument Box, Fnd. 1" Iron Pipe in Mon. Box / Set K.C. Monument, K.C. Monument, K.C. Monument).

P.A. 345 1990 KENT COUNTY

PEER APPROVED 3/7/96

CHAIRMAN [Signature]

Note: This corner is not common with A-4, T5N, R10W.

This corner was originally approved by the Kent County Remonumentation Peer Group and monumented by William Byl on 8/29/83 and was recorded per L.C.R.C. #3579.

B. Description of corner evidence found and/or method applied in restoring or reestablishing corner:

M-4 Found a Standard Kent County Monument 0.5' West of C/L of Patterson Avenue per L.C.R.C.'s # 3579, #5985 and #7191 as set by William Byl in place of a 1" iron pipe he found in a monument box which checked K.C. Surveyor's records.

L.C.R.C. #3579

L.C.R.C. #5985

L.C.R.C. #7191

Table with 3 columns corresponding to L.C.R.C. #3579, #5985, and #7191. Rows describe corner evidence: Nail & tag, NW cor. brick veneer, SW cor. garage fdn., NE cor. fdn., W 1/4 cor. Sec 7, 5-10, and W 1/4 cor. Sec 5, 5-10.

The selected location is accepted by me and is generally accepted by professional surveyors as the best available evidence of the position of the original corner.

C. Description of monument for corner and accessories established to perpetuate locating the position of the corner:

M-4 Standard Kent County Monument

- Nail & K.C. remon. tag on P. Pole N 60° W 37.03'
NW cor. brick veneer Hse. #7196 N 65° E 88.70'
SW cor. garage Hse. #7196 S 75° E 82.36'
NE cor. fndn. Hse. #7209 S 65° W 88.15'
W 1/4 cor. Sec. 7, T5N, R10W, (Kent County Monument) S 00° W 51.77'

Signed by [Signature] Date 7/23/96

EARTH TECH

Surveyor's Michigan License No. 25854

