SURVEY & REMONUMENTATION

FEB 14 1997

COMMISSION

LAND CORNER RECORDATION CERTIFICATE

Filing Requirement of Act 74, Mich. P.A. 1970

KENT COUNTY REMONUMENTATION

For corners in Kent (County) Located in: Gaines Township Corner Code #

STATE OF MICHIGAN COUNTY OF KENT RECEIVED FOR RECORD 96 AUG -8 AM 8:48 REG. OF DEEDS 9330

Register of Deeds Stamp & File Number

1. Public Land Survey T 5N R 11W M-5
   T ____ R ____
   T ____ R ____
   T ____ R ____
2. Property Controlling S ____ T ____ R ____
   in Section S ____ T ____ R ____
3. Miscellaneous S ____ T ____ R ____
   Property in Sec. S ____ T ____ R ____

4. Lot No. ____, Recorded Plat ____
5. Private Claims ____

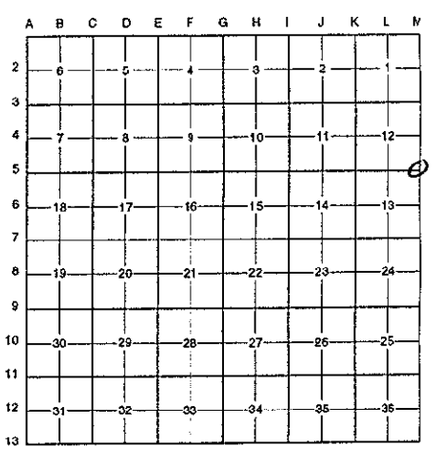

I, Randy Kolehouse, in a field survey on January 3 19 96, do hereby certify that under requirements of P.A. 74 Michigan P.A. of 1970, the corner points mentioned in lines 1 and 2 above were in conformance with regulations and rules therefore as required in the current manual of survey instructions of the United States Department of the interior, Bureau of Land Management or by a decree of a Court of Law and/or that the corner points mentioned in lines 3, 4 and 5 above were in conformance with the rules of the Michigan Board of Land Surveyors or by a Decree of a Court of Law; established, re-established, monumented, re-monumented, recovered, found as expressed below:

NOTE: Not more than 4 corners, all in the same town and range, may be recorded on this certificate.

A. Description of original monument and accessories and/or subsequent restoration:

M-5	1817	G.L.O. Notes	L. Lyon	Set Post
	1965	Witness Map	K.C. Surveyor	Monument Box
	1976	L.C.R.C. #959	McPherson	3/4" Iron in Mon. Box
	1981	L.C.R.C. #2156	Jonker Land Surveys	Fnd. 1/2" Iron in Mon. Box & Conc. Mon. / Set K.C. Monument
	1991	L.C.R.C. #5986	William Byle	K.C. Monument
	1994	L.C.R.C. #7190	Glaza & Associates	K.C. Monument

P.A. 345 1990 KENT COUNTY
PEER APPROVED 3/7/96
CHAIRMAN Harry Huber

Note: This corner is not common with A-5, T5N, R10W.

This corner was originally approved by the Kent County Remonumentation Peer Group and monumented by Rob Jonker on 9/1/81 and was recorded per L.C.R.C. #2156.

B. Description of corner evidence found and/or method applied in restoring or reestablishing corner:

M-5 Found a Standard Kent County Monument on the C/L of Patterson Avenue (bit.) on line of the center of 76th Street (bit.) running West and 20' M/L North of the C/L intersection of 76th Street running East and 35.44' North of A-5, T5N, R10W, per L.C.R.C.'s #2156, #5986 and #7190, as set by Rob Jonker over the top of a 4" concrete monument in place of a 1/2" iron in a monument box he found that checked L.C.R.C. #959.

L.C.R.C. #2156	L.C.R.C. #5986	L.C.R.C. #7190
Remon. tag on N side p. pole S 85° E 69.37'	Nail & KC Remon. tag N. side P. Pole S 85° E 69.34'	Nail & KC remon. tag in North side P. Pole S 85° E 69.34'
Iron in mon. box, South 35.41'	Kent Co. Mon. (SW cor. Sec. 7-5-10) in Mon. Box S 00° W 35.44'	Kent County Monument (SW cor. Sec 7-5-10) in mon box S 00° W 35.44'
Chisel mark on E. end road culv. N 23° E 51.83'	Chisel mark on E. end road culv. N 23° E 51.83'	Chisel mark on East end of road culvert N 23° E 51.83' (m. 51.85')
SW corner conc. H/W N 17° W 47.70'	SW corner conc. H/W N 17° W 47.70'	SW corner conc. H/W N 17° W 47.70'
In line with C/L extended to West	Set Nail & KC Remon. tag N. side Guy Pole S 70° W 86.51'	Nail & K.C. remon tag in North side guy pole S 70° W 86.51'

The selected location is accepted by me and is generally accepted by professional surveyors as the best available evidence of the position of the original corner.

C. Description of monument for corner and accessories established to perpetuate locating the position of the corner:

M-5 Standard Kent County Monument

Nail & K.C. remon. tag on N side P. pole S 85° E 69.34'
Nail & K.C. remon. tag on N side Guy pole S 70° W 86.51'
SW cor. conc. headwall N 17° W 47.70'
Chisel mark end culvert N 23° E 51.85'
K.C. Mon. Sec 7, T5N, R10W, S 00° W 35.44'

STATE OF MICHIGAN RANDY J. KOLEHOUSE LAND SURVEYOR No. 25854 LICENSED LAND SURVEYOR

Signed by Randy J. Kolehouse Date 7/23/96
EARTH TECH

Surveyor's Michigan License No. 25854

FORM APPROVED BY MICHIGAN STATE BOARD OF LAND SURVEYORS, JAN. 28, 1971
REVISED MAY 14, 1975
REVISED JAN., 1983