

FEB 14 1997

COMMISSION

LAND CORNER RECORDATION CERTIFICATE
Filing Requirement of Act 74, Mich. P.A. 1970
KENT COUNTY REMONUMENTATION

For corners in


Table with columns: Kent (County), Located in: Gains Township, Corner Code #. Rows include Public Land Survey, Property Controlling in Section, and Miscellaneous Property in Sec.

STATE OF MICHIGAN
COUNTY OF KENT
RECEIVED FOR RECORD
96 AUG -8 AM 8:48
REG. OF DEEDS
Luis Standa

9332

Register of Deeds Stamp & File Number

4. Lot No. \_\_\_\_\_, Recorded Plat \_\_\_\_\_
5. Private Claims \_\_\_\_\_

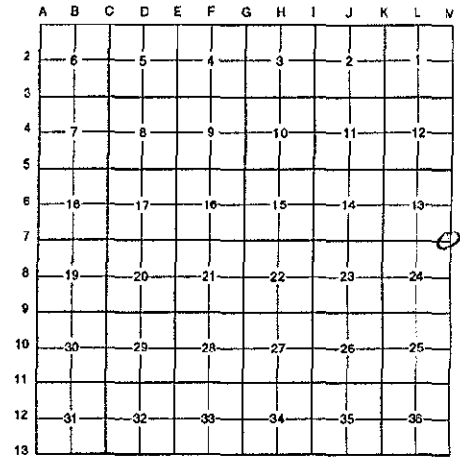

I, Randy Kolehouse, in a field survey on January 3, 1996, do hereby certify that under requirements of P.A. 74 Michigan P.A. of 1970, the corner points mentioned in lines 1 and 2 above were in conformance with regulations and rules therefore as required in the current manual of survey instructions of the United States Department of the interior, Bureau of Land Management or by a decree of a Court of Law and/or that the corner points mentioned in lines 3, 4 and 5 above were in conformance with the rules of the Michigan Board of Land Surveyors or by a Decree of a Court of Law; established, re-established, monumented, re-monumented, recovered, found as expressed below:

NOTE: Not more than 4 corners, all in the same town and range, may be recorded on this certificate.

A. Description of original monument and accessories and/or subsequent restoration:

Table with 4 columns: Date (1817-1994), Description (G.L.O. Notes, Witness Map, L.C.R.C. #s), Name (L. Lyon, K.C. Surveyor, McPherson, R. Jonker, William Byl, Glaza & Associates), and Monument Type (Set Post, Iron, Iron in Monument Box, Fnd. Iron in Mon. Box / Set K.C. Monument, K.C. Monument, K.C. Monument).

Note: This corner is not common with A-7, T5N, R10W.

This corner was originally approved by the Kent County Remonumentation Peer Group and monumented by Rob Jonker on 9/2/81 and was recorded per L.C.R.C. #2155.

P.A. 345 1990 KENT COUNTY
PEER APPROVED 3/6/96
CHAIRMAN Randy Kolehouse

B. Description of corner evidence found and/or method applied in restoring or reestablishing corner:

M-7 Found a Standard Kent County Monument 13.50' North of A-7, T5N, R10W, on the C/L of Patterson Avenue (bit.) running North and South 5' M/L North of the intersection of 84th Street (bit.) running East and West per L.C.R.C.'s #2155, #5988 and #7194 as set by Rob Jonker in place of a 1/2" iron in a monument box over a 3/4" iron (18" below grade) that checked L.C.R.C. #959.

L.C.R.C. #2155 L.C.R.C. #5988 L.C.R.C. #7194

Table with 3 columns: L.C.R.C. #2155, L.C.R.C. #5988, L.C.R.C. #7194. Rows describe monument locations and bearings (e.g., Remon. tag on S side t. pole N 67° E 59.48', Kent Co. Mon. (NW cor. Sec. 19-5-10) in Mon. Box S 00° W 13.50').

The selected location is accepted by me and is generally accepted by professional surveyors as the best available evidence of the position of the original corner.

C. Description of monument for corner and accessories established to perpetuate locating the position of the corner:

M-7 Standard Kent County Monument

- Nail & K.C. remon. tag on N side 14" Blk. Oak N 53° W 52.49'
Nail & K.C. remon. tag on E side P. pole N 20° W 59.21'
SW cor. fndn. hse. #4823 N 70° E 175.55'
Nail & K.C. remon. tag on S side P. pole N 67° E 59.47'
Nail & K.C. remon. tag on SE side P. pole S 37° W 57.26'
K.C. Mon. NW cor. 19, T5N, R10W, S 00° W 13.50'

Signed by Randy J. Kolehouse Date 7/23/96
EARTH TECH
Surveyor's Michigan License No. 25854

