

FEB 14 1997

COMMISSION

LAND CORNER RECORDATION CERTIFICATE
Filing Requirement of Act 74, Mich. P.A. 1970
KENT COUNTY REMONUMENTATION

For corners in

Table with columns: Kent (County), Located in: Gains Township, Corner Code #. Rows include Public Land Survey, Property Controlling in Section, and Miscellaneous Property in Sec.

REG. OF DEEDS

9333

Register of Deeds Stamp & File Number

96 AUG -8 AM 8:48

STATE OF MICHIGAN
COUNTY OF KENT
RECEIVED FOR RECORD

- 4. Lot No. , Recorded Plat
5. Private Claims

I, Randy Kolehouse, in a field survey on January 5 19 96, do hereby certify that under requirements of P.A. 74 Michigan P.A. of 1970, the corner points mentioned in lines 1 and 2 above were in conformance with regulations and rules therefore as required in the current manual of survey instructions of the United States Department of the Interior, Bureau of Land Management or by a decree of a Court of Law and/or that the corner points mentioned in lines 3, 4 and 5 above were in conformance with the rules of the Michigan Board of Land Surveyors or by a Decree of a Court of Law; established, re-established, monumented, re-monumented, recovered, found as expressed below:

NOTE: Not more than 4 corners, all in the same town and range, may be recorded on this certificate.

A. Description of original monument and accessories and/or subsequent restoration:

Table with columns: M-8, Date, Description, Name, Monument Type. Includes entries for G.L.O. Notes, Witness Map, L.C.R.C. #959, #2150, #5989, #7166.

Note: This corner is not common with A-8, T5N, R10W.

This corner was originally approved by the Kent County Remonumentation Peer Group and monumented by Jonker Land Surveys on 8/31/81 and was recorded per L.C.R.C. #2150.

B. Description of corner evidence found and/or method applied in restoring or reestablishing corner:

M-8 Found a Standard Kent County Monument 39.01' North of A-8, T5N, R10W, on the C/L of Patterson Avenue running N-S on line of power lines running West per L.C.R.C.'s #2150, #5989 and #7166 as set by Rob Jonker to replace a 1/2" pipe he found which checked L.C.R.C. #959 and K.C. Surveyor's records.

Table with columns: L.C.R.C. #2150, L.C.R.C. #5989, L.C.R.C. #7166. Rows describe monument tags and bearings for each L.C.R.C. number.

The selected location is accepted by me and is generally accepted by professional surveyors as the best available evidence of the position of the original corner.

C. Description of monument for corner and accessories established to perpetuate locating the position of the corner:


M-8 Standard Kent County Monument

- Nail & K.C. remon. tag on E side 24" Oak S 15° W 136.13'
Nail & K.C. remon. tag on N side P. pole S 70° W 38.03'
Nail & K.C. remon. tag on S side 10"-15" Maples Clump S 80° E 23.98'
K.C. Monument W 1/4 19, T5N, R10W, S 00° W 39.01'

Signed by Randy J. Kolehouse
EARTH TECH

Date 7/23/96

Surveyor's Michigan License No. 25854

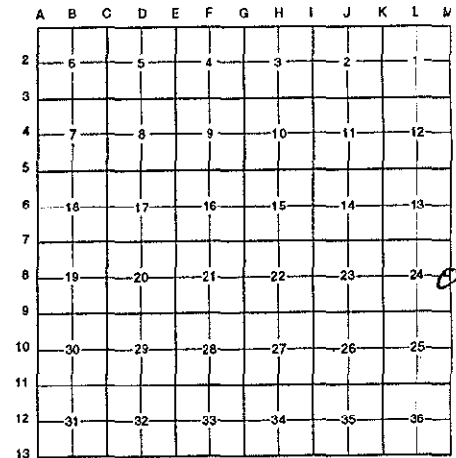

P.A. 345 1990 KENT COUNTY
PEER APPROVED 3/17/96
CHAIRMAN Harry Kolehouse

