

FEB 14 1997

COMMISSION

LAND CORNER RECORDATION CERTIFICATE  
Filing Requirement of Act 74, Mich. P.A. 1970  
KENT COUNTY REMONUMENTATION

For corners in


Kent (County)	Located in: Gaines Township	Corner Code #
1. Public Land Survey	T <u>5N</u> R <u>11W</u>	<u>M-10</u>
	T _____ R _____	_____
	T _____ R _____	_____
	T _____ R _____	_____
2. Property Controlling in Section	S _____ T _____ R _____	_____
	S _____ T _____ R _____	_____
3. Miscellaneous Property in Sec.	S _____ T _____ R _____	_____
	S _____ T _____ R _____	_____

STATE OF MICHIGAN  
COUNTY OF KENT  
RECEIVED FOR RECORD  
96 AUG -8 AM 8:48  
REG. OF DEEDS  
*Lucy St. Paul*  
9335  
Register of Deeds Stamp & File Number

4. Lot No. \_\_\_\_\_, Recorded Plat \_\_\_\_\_  
5. Private Claims \_\_\_\_\_

I, Randy Kolehouse, in a field survey on January 5 19 96, do hereby certify that under requirements of P.A. 74 Michigan P.A. of 1970, the corner points mentioned in lines 1 and 2 above were in conformance with regulations and rules therefore as required in the current manual of survey instructions of the United States Department of the Interior, Bureau of Land Management or by a decree of a Court of Law and/or that the corner points mentioned in lines 3, 4 and 5 above were in conformance with the rules of the Michigan Board of Land Surveyors or by a Decree of a Court of Law; established, re-established, monumented, re-monumented, recovered, found as expressed below:

NOTE: Not more than 4 corners, all in the same town and range, may be recorded on this certificate.

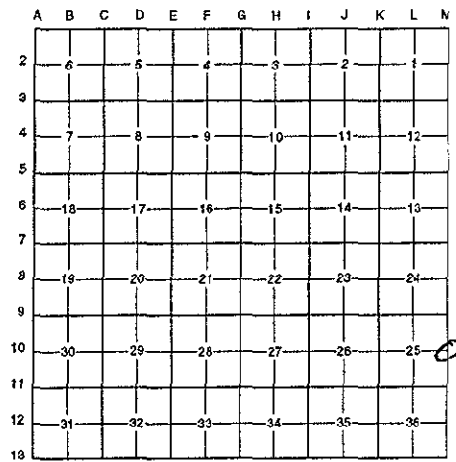

A. Description of original monument and accessories and/or subsequent restoration:

M-10	1817	G.L.O. Notes	L. Lyon	Set Post
	N/A	Witness Map	K.C. Surveyor	3/4" Iron
	1976	L.C.R.C. #958	McPherson	3/4" Iron
	1981	L.C.R.C. #2151	Rob Jonker	Fnd. 3/4" Iron / Set K.C. Monument
	1991	L.C.R.C. #5991	William Byl	K.C. Monument
	1993	L.C.R.C. #7195	Glaza & Associates	K.C. Monument

P.A. 345 1990 KENT COUNTY  
PEER APPROVED 3/18/96  
*Harry Fisher*  
CHAIRMAN

Note: This corner is not common with A-10, T5N, R10W.

This corner was originally approved by the Kent County Remonumentation Peer Group and monumented by Rob Jonker on 8/31/81 and was recorded per L.C.R.C. #2151.

B. Description of corner evidence found and/or method applied in restoring or reestablishing corner:

M-10 Found a Standard Kent County Monument 13.29' North of A-10, T5N, R10W, 5' M/L West of the C/L of Patterson Avenue (bit.) running North & South 6' North of a brush row running East per L.C.R.C.'s #2151, #5991 and #7195 as set by Rob Jonker in place of a 3/4" iron he found that checked L.C.R.C. #959.

L.C.R.C. #2151

L.C.R.C. #5991

L.C.R.C. #7195

Remon. tag on E. side p. pole N 15° W 106.31'  
Iron South 13.30'

Nail & KC Remon. tag E. side P. Pole  
N 15° W 106.29'  
Kent Co. Mon. (W 1/4 cor. Sec. 30-5-10)  
S 00° W 13.30'  
Nail & KC Remon. tag W. side 10" Hickory  
S 10° E 149.10'

Nail & K.C. remon tag in East side P. pole  
N 15° W 106.29' (m. 106.31')  
Kent Co Monument (W 1/4 cor, Sec 30-5-10)  
S 00° W 13.30' (m. 13.29')  
Nail & K.C. remon tag in West side 12: Hickory (Ash)  
S 10° E 149.21' (m. 149.16')  
Centerline of road 5' ± East

The selected location is accepted by me and is generally accepted by professional surveyors as the best available evidence of the position of the original corner.

C. Description of monument for corner and accessories established to perpetuate locating the position of the corner:

M-10 Standard Kent County Monument

Nail & K.C. remon. tag on S side 8" Trip. Maple S 85° E 73.29'  
Nail & K.C. remon. tag on W side 12" Ash S 10° E 149.16'  
Nail & K.C. remon. tag on E side 2" P. pole S 15 W 160.02'

Nail & K.C. remon. tag on E side P. pole N 15° W 106.31'  
K.C. Monument W 1/4 30, T5N, R10W, S 00° W 13.29'

Signed by *Randy J. Kolehouse* Date 7/23/96  
EARTH TECH  
Surveyor's Michigan License No. 25854

