

FEB 14 1997

COMMISSION

LAND CORNER RECORDATION CERTIFICATE
Filing Requirement of Act 74, Mich. P.A. 1970
KENT COUNTY REMONUMENTATION

For corners in


Table with columns: Kent (County), Located in: Gains Township, Corner Code #. Rows include Public Land Survey, Property Controlling in Section, and Miscellaneous Property in Sec.

STATE OF MICHIGAN
COUNTY OF KENT
RECEIVED FOR RECORD
96 AUG -8 AM 8:48
REG. OF DEEDS

9336

Register of Deeds Stamp & File Number

- 4. Lot No. , Recorded Plat
5. Private Claims

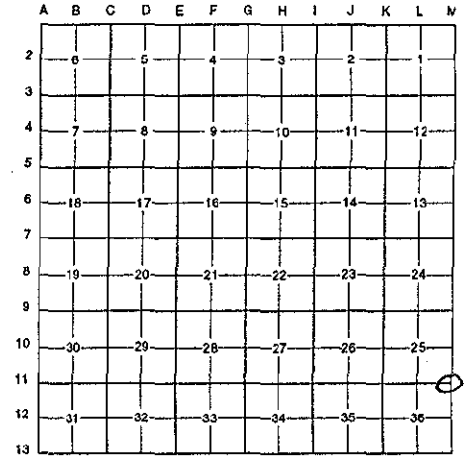

I, Randy Kolehouse, in a field survey on January 3, 1996, do hereby certify that under requirements of P.A. 74 Michigan P.A. of 1970, the corner points mentioned in lines 1 and 2 above were in conformance with regulations and rules therefore as required in the current manual of survey instructions of the United States Department of the Interior, Bureau of Land Management or by a decree of a Court of Law and/or that the corner points mentioned in lines 3, 4 and 5 above were in conformance with the rules of the Michigan Board of Land Surveyors or by a Decree of a Court of Law; established, re-established, monumented, re-monumented, recovered, found as expressed below:

NOTE: Not more than 4 corners, all in the same town and range, may be recorded on this certificate.

A. Description of original monument and accessories and/or subsequent restoration:

Table with columns: M-11, L.C.R.C. #, G.L.O. Notes, L. Lyon, K.C. Surveyor, Set Post. Includes entries for 1817, 1935, 1976, 1981, 1991, and 1994.

P.A. 345 1990 KENT COUNTY
PEER APPROVED 3/6/96
CHAIRMAN [Signature]

Note: This corner is not common with A-11, T5N, R10W.

This corner was originally approved by the Kent County Remonumentation Peer Group and monumented by Rob Jonker on 9/22/81 and was recorded per L.C.R.C. #2157.

B. Description of corner evidence found and/or method applied in restoring or reestablishing corner:

M-11 Found a Standard Kent County Monument 11.88' North of A-11, T5N, R10W, on the C/L of Patterson Avenue (bit.) running N-S 9' North of the C/L of 100th Street (bit.) running E-W per L.C.R.C.'s #2157, #5992 and #7196 as set by Rob Jonker in place of a 1/2" rebar set by McPherson at Gov. Dist. (11.88') North of A-11, T5N, R10W.

Table with columns: L.C.R.C. #2157, L.C.R.C. #5992, L.C.R.C. #7196. Describes monument details like 'Iron in mon. box', 'Nail & KC Remon. tag', and 'NW corner brick veneer Hse. #4802'.

The selected location is accepted by me and is generally accepted by professional surveyors as the best available evidence of the position of the original corner.

C. Description of monument for corner and accessories established to perpetuate locating the position of the corner:

Table with columns: M-11, Standard Kent County Monument. Lists monument details like 'Nail & K.C. remon. tag on E side 5" Elm Clump', 'Nail & K.C. remon. tag on SW side E P. pole', etc.

Signed by [Signature] Date 7/23/96

Surveyor's Michigan License No. 25854

