

SURVEY & MONUMENTATION

\$7.00
\$2.00

JAN 23 1996

COMMISSION

LAND CORNER RECORDATION CERTIFICATE
Filing Requirement of Act 74, Mich. P.A. 1970
KENT COUNTY REMONUMENTATION

For corners in

Kent (County)	Located in:	Corner Code #
1. Public Land Survey	T <u>5N</u> R <u>11W</u>	<u>B-6</u>
	T _____ R _____	_____
	T _____ R _____	_____
	T _____ R _____	_____
2. Property Controlling in Section	S _____ T _____ R _____	<u>Seg. 2</u>
	S _____ T _____ R _____	_____
3. Miscellaneous Property in Sec.	S _____ T _____ R _____	_____
	S _____ T _____ R _____	_____
4. Lot No. _____, Recorded Plat _____		
5. Private Claims _____		


Seg 2

REG. OF DEEDS
Lucy J. ...
8901

STATE OF MICHIGAN
COUNTY OF KENT
RECEIVED FOR RECORD
95 DEC 28 PM 2:20

Register of Deeds Stamp & File Number

I, Randy Kolehouse, in a field survey on _____ 19 95, do hereby certify that under requirements of P.A. 74 Michigan P.A. of 1970, the corner points mentioned in lines 1 and 2 above were in conformance with regulations and rules therefore as required in the current manual of survey instructions of the United States Department of the Interior, Bureau of Land Management or by a decree of a Court of Law and/or that the corner points mentioned in lines 3, 4 and 5 above were in conformance with the rules of the Michigan Board of Land Surveyors or by a Decree of a Court of Law; established, re-established, monumented, re-monumented, recovered, found as expressed below:

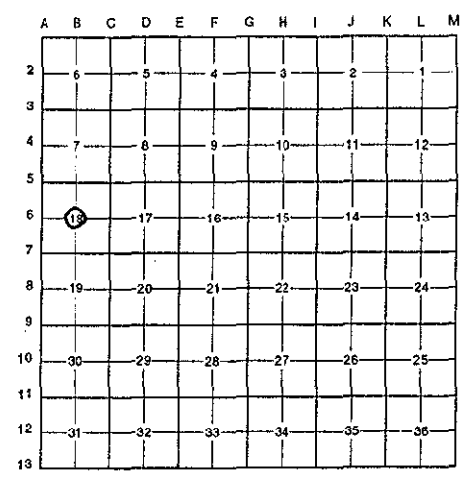

NOTE: Not more than 4 corners, all in the same town and range, may be recorded on this certificate.

A. Description of original monument and accessories and/or subsequent restoration:

B-6	1946-1963 Survey Notes	Williams & Works	Found Iron 3.5' N of Cor. Fence Post
	1963 Wit. Map	K.C. Surveyor	Found Iron 3.5' N of Cor. Fence Post
	1973 L.C.R.C. #553	Medema, Van Kooten & Assoc.	Found 1" Iron
	1993 L.C.R.C. #6832A	Chris Marschall	Replaced 3/4" Iron Pipe with K.C. Monument

B. Description of corner evidence found and/or method applied in restoring or reestablishing corner:

B-6 Found K.C. Monument per L.C.R.C. #6832 0.2' S and 2.15' W of true center. This position checks with L.M.N. measure. Accepted Kent County Monument as Center Section.

L.C.R.C. #6832A

- Fence corner post with fence running S & W South 2' more or less
- Fence corner post with fence running S & E South 3.7' more or less
- Fence corner post with fence running S & E South 16.1' more or less
- Nail & Tag NE sd 12" Mulberry S50° E 5.15'
- Nail & Tag W sd 42" Oak S03° W 61.62'
- Nail & Tag S sd 6" Ash S75° W 7.90'
- Nail & Tag N sd 6" Cherry N80° W 18.94'
- Nail & Tag SW sd 16" Maple N50° W 26.62'
- Centerline of a small creek North 8' more or less
- Nail & Tag S sd 4" Ash N60° E 20.73'

P.A. 345 1990 KENT COUNTY
PEER APPROVED 10/26/95
CHAIRMAN *Harry Stuber*

C. Description of monument for corner and accessories established to perpetuate locating the position of the corner:

B-6 Found Standard 4" x 30" Kent County Monument.

- Fence corner post with fence running S & W South 2' more or less
- Fence corner post with fence running S & E South 3.7' more or less
- Fence corner post with fence running S & E South 16.1' more or less
- Nail & K.C. remon. tag in NE sd 12" Mulberry S50° E 5.15'
- Nail & K.C. remon. tag in W sd 42" Oak S03° W 61.62'
- Nail & K.C. remon. tag in S sd 6" Ash S75° W 7.90'
- Nail & K.C. remon. tag in N sd 6" Cherry N80° W 18.94'
- Nail & K.C. remon. tag in SW sd 16" Maple N50° W 26.62'
- Nail & K.C. remon. tag in S sd 4" Ash N60° E 20.73'
- Centerline of a small creek North 8' more or less



Signed by *Randy J. Kolehouse*
EARTH TECH

Date 12/22/95

Surveyor's Michigan License No. 25854