

**SURVEY & REMONUMENTATION**

MAY 28 1997

COMMISSION

**LAND CORNER RECORDATION CERTIFICATE**  
**Filing Requirement of Act 74, Mich. P.A. 1970**  
**KENT COUNTY REMONUMENTATION**

For corners in

Kent (County)	Located in: Gaines Township	Corner Code #
1. Public Land Survey	T <u>5N</u> R <u>11W</u>	<u>M-1</u>
	T _____ R _____	_____
	T _____ R _____	_____
	T _____ R _____	_____
2. Property Controlling in Section	S _____ T _____ R _____	<u>Seg. 2</u>
	S _____ T _____ R _____	_____
3. Miscellaneous Property in Sec.	S _____ T _____ R _____	_____
	S _____ T _____ R _____	_____


STATE OF MICHIGAN  
 COUNTY OF KENT  
 RECEIVED FOR RECORD  
 96 AUG -8 AM 8:47  
 REG. OF DEEDS  
*Lucy St. Louis*

9326

Register of Deeds Stamp & File Number

4. Lot No. \_\_\_\_\_, Recorded Plat \_\_\_\_\_  
 5. Private Claims \_\_\_\_\_

I, Randy Kolehouse, in a field survey on January 3 19 96, do hereby certify that under requirements of P.A. 74 Michigan P.A. of 1970, the corner points mentioned in lines 1 and 2 above were in conformance with regulations and rules therefore as required in the current manual of survey instructions of the United States Department of the interior, Bureau of Land Management or by a decree of a Court of Law and/or that the corner points mentioned in lines 3, 4 and 5 above were in conformance with the rules of the Michigan Board of Land Surveyors or by a Decree of a Court of Law; established, re-established, monumented, re-monumented, recovered, found as expressed below:

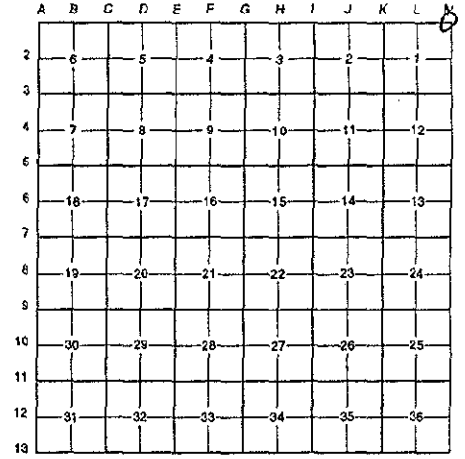

NOTE: Not more than 4 corners, all in the same town and range, may be recorded on this certificate.

A. Description of original monument and accessories and/or subsequent restoration:

M-1	1817	G.L.O. Notes	L. Lyon	Set Post
	1944	Witness Map	K.C. Surveyor	1-1/2" Iron
	1975	L.C.R.C. #898	Exxel Engineering	1/2" Iron
	1982	L.C.R.C. #3182	Jonker Land Surveys	Fnd. 1/2" Iron & 1-1/2" Iron / Set K.C. Monument
	1989	L.C.R.C. #4991	J. Bueche	K.C. Monument
	1993	L.C.R.C. #6757	R. Roon	K.C. Monument
	1994	L.C.R.C. #7718	William Byl	K.C. Monument

P.A. 345 1990 KENT COUNTY  
 PEER APPROVED 3/27/96  
 CHAIRMAN [Signature]

Note: This corner is common with M-13, T6N, R11W; A-13, T6N, R10W, & A-1, T5N, R10W.

This corner was originally approved by the Kent County Remonumentation Peer Group and monumented by Rob Jonker on 11/23/82 and was recorded per L.C.R.C. #3182.

B. Description of corner evidence found and/or method applied in restoring or reestablishing corner:

M-1 Found a Standard Kent County Monument per witnesses from above L.C.R.C. as set by Rob Jonker in place of the 1/2" x 24" iron he found over a 1 1/2" iron 27" deep. Both irons check with Kent County Witness and L.C.R.C. 898.

L.C.R.C. #3182  
 Remon. tag on SE side t. pole S 50° W 34.97'  
 Remon. tag on SE side p. pole N 60° E 48.52'  
 NW corner house fnd. S 30° E 159.36'

L.C.R.C. #4991  
 Nail & Remon Tag on SE side t. pole S 50° W 35.28'  
 Nail & Remon Tag on SE side p. pole N 60° E 48.52'  
 NW cor house fnd S 30° E 159.36'

L.C.R.C. #6757  
 Nail & KC Remon. tag SE side P. Pole S 55° W 35.30'  
 Nail & KC Remon. tag SE side P. Pole N 60° E 48.65'  
 NW cor. hse. fnd. S 30° E 159.36'

L.C.R.C. #7718  
 Nail & KC Remon. tag SE side P. Pole S 55° W 35.30'  
 Nail & KC Remon. tag E. side Guy Pole S 25° E 68.64'  
 Nail & KC Remon. tag SW side P. Pole S 50° E 50.81'  
 Nail & KC Remon. tag SE side P. Pole N 60° E 48.65'  
 NW cor. hse. fnd. S 30° E 159.36'

The \_\_\_\_\_ accepted by me and is generally accepted by professional surveyors as the best available evidence of \_\_\_\_\_ corner.

C. \_\_\_\_\_ and accessories established to perpetuate locating the position of the corner:

\_\_\_\_\_ Pole S 55° W 35.30'  
 \_\_\_\_\_ S 25° E 68.64'  
 \_\_\_\_\_ E 50.81'  
 \_\_\_\_\_ 9.65'

Date 7/23/96

