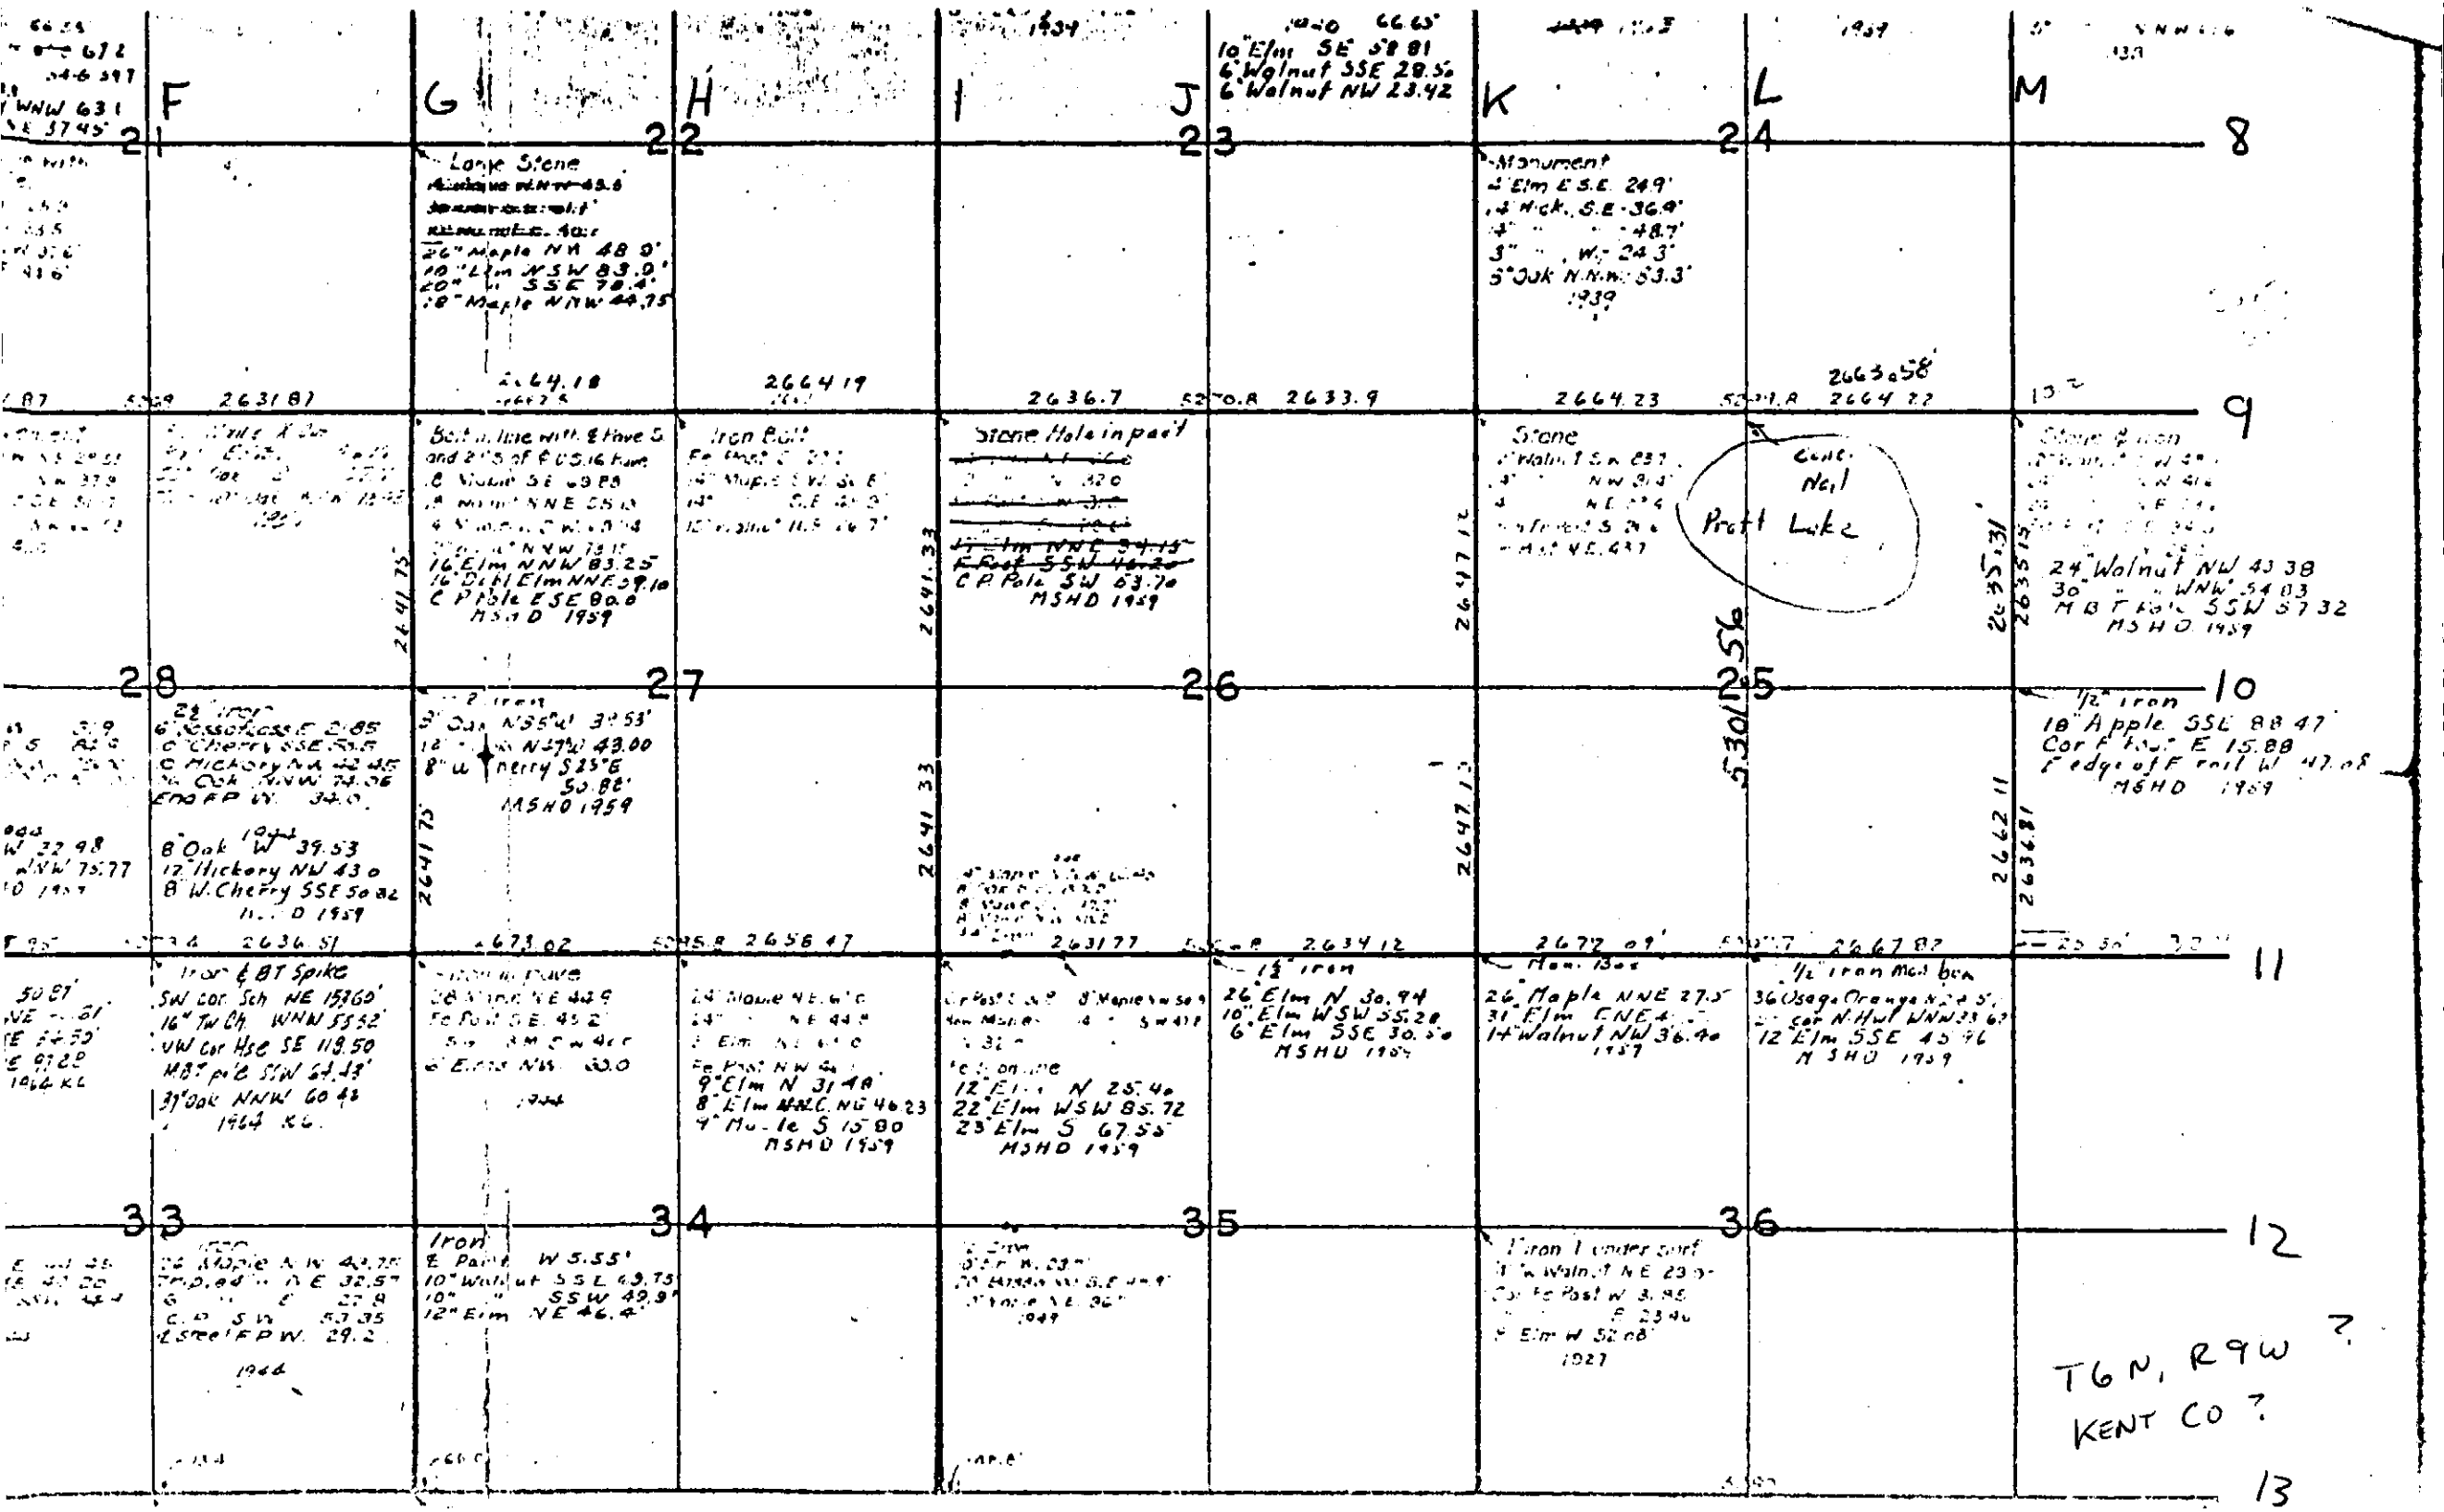

F
G
H
I
J
K
L
M
21
22
23
24
8
9
28
27
26
25
10
11
33
34
35
36
12
13
Large Stone
26" Maple NW 48.0'
10" Elm NSW 83.0'
20" " SSE 78.4'
18" Maple NNW 44.75'
10" Elm SE 58.81
6" Walnut SSE 28.56
6" Walnut NW 23.42
Monument
4" Elm E.S.E. 24.9'
14" Hick. S.E. 36.9'
3" " W. 24.3'
5" Oak N.N.W. 53.3'
1939
2631.87
2664.18
2664.19
2636.7
2633.9
2664.23
2663.58
2664.22
Bolt in line with ℄ Pave S. and 2" S of ℄ US 16 Pave
16" Elm NNW 83.25
16" Dbl Elm NNE 59.10
C P Pole ESE 80.0
MSHD 1959
Iron Bolt
Stone Hole in part
C P Pole SW 63.70
MSHD 1959
Stone
Conc. Nail
Pratt Lake
24" Walnut NW 43.38
30" " WNW 54.03
M B T Pole SSW 57.32
MSHD 1959
2641.75
2641.33
2647.12
2635.31
2635.15
2636.51
2673.02
2658.47
2631.77
2634.12
2672.09
2667.82
2662.11
2636.81
1/2" iron
18" Apple SSE 88.47
Cor F Post E 15.88
E edge of F rail W 47.08
MSHD 1959
Iron & BT Spike
SW cor Sch NE 153.60'
16" Tw Ch WNW 55.52'
NW Cor Hse SE 118.50
MBT pole SSW 64.43'
37" Oak NNW 60.42
1964 KC
Iron in Pave
9" Elm N 31.48
8" Elm NNE 46.23
9" Maple S 15.80
MSHD 1959
12" Elm N 25.40
22" Elm WSW 85.72
23" Elm S 67.55
MSHD 1959
1/2" iron
26" Elm N 30.94
10" Elm WSW 55.28
6" Elm SSE 30.50
MSHD 1959
Man. Box
26" Maple NNE 27.5
31" Elm ENE
14" Walnut NW 36.40
1959
1/2" iron Mon box
36 Osage Orange
12" Elm SSE 45.96
MSHD 1959
Iron
℄ Pave W 5.55'
10" Walnut SSE 69.75
10" " SSW 49.9'
12" Elm NE 46.4'
1944
Iron 1 under surf
1927
T6N, R9W ?
KENT CO ?