

**SURVEY & REMONUMENTATION**

FEB 14 1997

COMMISSION

**KENT COUNTY REMONUMENTATION  
LAND CORNER RECORDATION CERTIFICATE**  
Filing Requirement of Act 74, Mich. P.A. 1970

For corners in  
KENT COUNTY  
(County)

Located In: #

Corner Code #

1. Public Land Survey	T6N R 9W	A-4
	T R	
	T R	
	T R	
	T R	
2. Property Controlling in Section	S T R	
	S T R	
3. Miscellaneous Property in Sec.	S T R	
	S T R	

4. Lot No. \_\_\_\_\_, Recorded Plat \_\_\_\_\_  
5. Private Claims \_\_\_\_\_

I, Kirk Breitels, in a field survey on Feb. 12, 1996 do hereby state that under requirements of P.A. 74, Michigan P.A. of 1970, the corner points mentioned in lines 1 and 2 above were in conformance with regulations and rules therefore as required in the current manual of survey instructions of the United States Department of the Interior, Bureau of Land Management or by a decree of a Court of Law and /or that the corner points mentioned in lines 3, 4 and 5 above were in conformance with the rules of the Michigan Board of Land Surveyors or by a Decree of a Court of Law; established, re-established, monumented, recovered, found as expressed below:

NOTE: Not more than 2 corners, all in the same town and range, may be recorded on this certificate.

STATE OF MICHIGAN  
COUNTY OF KENT  
RECEIVED FOR RECORD  
96 MAR 20 AM 8:50  
REG. OF DEEDS  
*[Signature]*

9022

Register of Deeds Stamp & File Number

A	B	C	D	E	F	G	H	I	J	K	L	M
1												
2	6		5		4		3		2		1	
3												
4	7		8		9		10		11		12	
5												
6	18		17		16		15		14		13	
7												
8	19		20		21		22		23			
9												
10	30		29		28		27		26		25	
11												
12	31		32		33		34		35		36	
13												

P.A. 345 1990 KENT COUNTY

PEER APPROVED 3/7/96

CHAIRMAN *[Signature]*

A. Description of original monument and accessories and/or subsequent restoration:

A-4	1830	GLO	Mullett	Not Set
	1990	LCRC #5319	Chettleburgh	Set Kent County Monument
	1991	LCRC #6105	Unema	Kent County Monument

The position of this corner was previously approved by the Kent County Remonumentation Peer Group, monumented by Thomas Chettleburgh on 2/8/90 and was recorded per LCRC #5319

B. Description of corner evidence found and/or method applied in restoring or reestablishing corner:


A-4 Found standard Kent Co. Mon. (Harrison) per witnesses from above LCRC as set by Thomas Chettleburgh at the location per above LCRC (midway between A-3 & A-5).  
LCRC #5319 (Nail/tag in trees)

23" Oak N00°E 24.68'	10" Elm N40°E 29.58'	Nail/tag 24" Oak	N00°E 24.65'
12" Ash N70°E 22.34'	11" Ash S88°E 17.43'	Nail/tag 10" Elm	N40°E 29.55'
Tri. 10" Elm S40°E 1.08'		Nail/tag 12" Ash	N70°E 22.32'
KC Mon. (M-4, 6-10) S00°E 17.43'		Nail/tag Tri. 10" Elm	S40°E 1.08'
A-3 North 2625.71'	A-5 South 2625.72'	KC Mon. (M-4, 6-10)	S00°E 17.45'

The selected location is accepted by me and is generally accepted by professional surveyors as the best available evidence of the position of the corner.

C. Description of monument for corner and accessories established to perpetuate locating the position of the corner:

A-4 Standard Kent County Monument			
Nail & KC Remon. tag E. side 26" Oak	N00°E	24.62'	
Nail & KC Remon. tag NW side 12" Oak	N40°E	29.55'	
Nail & KC Remon. tag NW side 14" Ash	N70°E	22.32'	
Nail & KC Remon. tag SW side Tri. 12" Elm	S40°E	1.14'	
Kent Co. Mon. (M-4, T6N, R10W)	S00°E	17.45'	
On N-S fence line ±			
C/L creek is NE 8' ±			

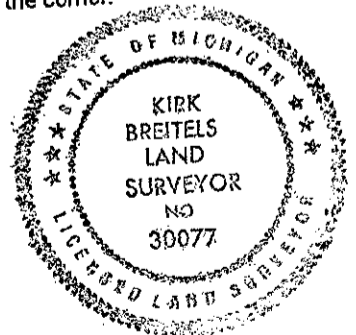

Signed by *[Signature]*  
Surveyor's Michigan License No. 30077

Date 3/2/96