

SURVEY & REMONUMENTATION

FEB 14 1997

KENT COUNTY REMONUMENTATION

COMMISSION LAND CORNER RECORDATION CERTIFICATE
Filing Requirement of Act 74, Mich. P.A. 1970

For corners in
KENT COUNTY
(County)

Located In:	Corner Code #
T 6N R 9W	A-5
T R	
T R	
T R	
S T R	
S T R	
S T R	
S T R	

1. Public Land Survey

2. Property Controlling in Section

3. Miscellaneous Property in Sec.

4. Lot No. _____, Recorded Plat _____

5. Private Claims _____

STATE OF MICHIGAN
COUNTY OF KENT
RECEIVED FOR RECORD

96 MAR 20 AM 8:50

REG. OF DEEDS

Lucy Bond

9023

Register of Deeds Stamp & File Number

I, Kirk Breitels, in a field survey on Feb. 12, 1996 do hereby state that under requirements of P.A. 74, Michigan P.A. of 1970, the corner points mentioned in lines 1 and 2 above were in conformance with regulations and rules therefore as required in the current manual of survey instructions of the United States Department of the Interior, Bureau of Land Management or by a decree of a Court of Law and /or that the corner points mentioned in lines 3, 4 and 5 above were in conformance with the rules of the Michigan Board of Land Surveyors or by a Decree of a Court of Law; established, re-established, monumented, recovered, found as expressed below:

NOTE: Not more than 2 corners, all in the same town and range, may be recorded on this certificate.

	A	B	C	D	E	F	G	H	I	J	K	L	M
1													
2	6	5	4	3	2	1							
3													
4	7	8	9	10	11	12							
5													
6	18	17	16	15	14	13							
7													
8	19	20	21	22	23	24							
9													
10	30	29	28	27	26	25							
11													
12	31	32	33	34	35	36							
13													

A. Description of original monument and accessories and/or subsequent restoration:

A-5	1830	GLO	Mullett	Set Post
	1940	Kent Co. Wit.		Conc. Monument
	1977	LCRC #1015	McCombs	Boat Spike
	1987	LCRC #4543	Meyer	Boat Spike
	1990	LCRC #5320	Chettleburgh	Set Kent County Monument
	1991	LCRC #6106	Unema	Kent County Monument

P.A. 345 1990 KENT COUNTY
PEER APPROVED 3/7/96
CHAIRMAN *Thomas Chettleburgh*

The position of this corner was previously approved by the Kent County Remonumentation Peer Group, monumented by Thomas Chettleburgh on 4/16/86 and was recorded per LCRC #5320

B. Description of corner evidence found and/or method applied in restoring or reestablishing corner:

A-5 Found standard Kent Co. Mon. (Harrison) per witnesses from above LCRC as set by Thomas Chettleburgh on Twp. Line in place of the Boat Spike he found. Said Boat Spike checks with Kent Co. Wit. and LCRC's #1015, #5320.


LCRC #5320	LCRC #6106	KC Mon.
Nail/tag 20" Hickory N23°E 62.54'	Nail/tag 24" Hickory N20°E 62.48'	(M-5, 6-10)
Nail/tag P. Pole N61°E 66.69'	Nail/tag P. Pole N60°E 66.70'	S00°E
Nail/tag 12" Hickory S80°E 28.30'	Nail/tag 14" Hickory S81°E 28.26'	28.25'
KC Mon. (M-5, 6-10) S00°E 28.25'	"X" cut on culv. N87°W 66.15'	
Nail/tag 15" Elm S21°W 107.69'	"X" cut on culv. S59°W 78.70'	

The selected location is accepted by me and is generally accepted by professional surveyors as the best available evidence of the position of the original corner.

C. Description of monument for corner and accessories established to perpetuate locating the position of the corner.

A-5 Standard Kent County Monument

New Nail & KC Remon. tag W. side	26" Hickory	N20°E	62.54'
Nail & KC Remon. tag NW side	P. Pole	N60°E	66.70'
Nail & KC Remon. tag S. side	14" Hickory	S81°E	28.29'
"X" cut on S. end conc. culvert		N87°W	66.15'
"X" cut on N. end conc. culvert		S59°W	78.80'
Kent Co. Mon. (M-5, T6N, R10W)		S00°E	28.25'
Tree Row to East is 3'± South			
C/L N-S road is West 0.5'±			

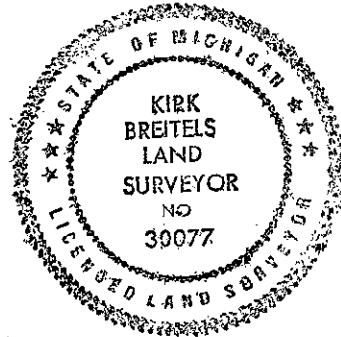

Signed by *Kirk Breitels*

Date 3/2/96

Surveyor's Michigan License No. 30077