

**SURVEY & REMONUMENTATION**

FEB 14 1997

**KENT COUNTY REMONUMENTATION**

**COMMISSION**

**LAND CORNER RECORDATION CERTIFICATE**  
Filing Requirement of Act 74, Mich. P.A. 1970

For corners in

**KENT COUNTY**

(County)

Located In:

Corner Code #

1. Public Land Survey

T 6N R 9W

A-8

2. Property Controlling in Section

S T R

3. Miscellaneous Property in Sec.

S T R

4. Lot No. \_\_\_\_\_, Recorded Plat \_\_\_\_\_  
5. Private Claims \_\_\_\_\_

I, Kirk Breitels, in a field survey on Apr. 3, 1996 do hereby state that under requirements of P.A. 74, Michigan P.A. of 1970, the corner points mentioned in lines 1 and 2 above were in conformance with regulations and rules therefore as required in the current manual of survey instructions of the United States Department of the Interior, Bureau of Land Management or by a decree of a Court of Law and/or that the corner points mentioned in lines 3, 4 and 5 above were in conformance with the rules of the Michigan Board of Land Surveyors or by a Decree of a Court of Law, established, re-established, monumented, recovered, found as expressed below:

NOTE: Not more than 2 corners, all in the same town and range, may be recorded on this certificate.

A. Description of original monument and accessories and/or subsequent restoration:

A-8	1830	GLO	Mullett	Not Set
	1941	Kent Co. Wit.		Iron
	1976	LCRC #1017	McCombs	Pipe
	1988	LCRC #4899	Chettleburgh	Set Kent County Monument
	1991	LCRC #6109	Unema	Kent County Monument

P.A. 345 1990 KENT COUNTY

PEER APPROVED 5/30/96  
CHAIRMAN Henry Huber

The position of this corner was previously approved by the Kent County Remonumentation Peer Group, monumented by Thomas Chettleburgh on 4/11/86 and was recorded per LCRC #4899

B. Description of corner evidence found and/or method applied in restoring or reestablishing corner:

A-8 Found BROKEN standard Kent Co. Mon. (Harrison) per witnesses from above LCRC as set by Thomas Chettleburgh on Twp. line in place of the Iron Pipe he found. Said Iron Pipe checks with Kent Co. Wit. and LCRC #1017. Repaired Kent County Monument.  
LCRC #4899 (Nail/tag in trees)      LCRC #6109 (Nail/tag in trees)


10" Elm N71°E 40.42'	Kent Co. Mon.	12" Elm N72°E 40.41'	Fc. Post N52°W 40.42'
Fc. Post S61°E 37.44'	South 16.01'	Fc. Post S60°E 37.58'	Kent Co. Mon.
9" Elm S50°E 37.06'		9" Elm S50°E 37.05'	South 16.01'
12" Tw. Elm S09°E 142.81'		Multi-Elm N07°W 170.45'	
Multi-Elm N06°W 170.44'		Tw. 14" Elm S08°E 142.90'	

The selected location is accepted by me and is generally accepted by professional surveyors as the best available evidence of the position of the corner.

C. Description of monument for corner and accessories established to perpetuate locating the position of the corner:

A-8 Standard Kent County Monument

Nail & KC Remon. tag NE side	fence post	N52°W	40.42'
Nail & KC Remon. tag NW side	14" Elm	N72°E	40.41'
Nail & KC Remon. tag E. side	Multi-Elm	N07°W	170.45'
Nail & KC Remon. tag W. side	Tw. 14" Elm	S08°E	142.90'
Set Nail & KC Remon. tag SW side	fence post	S45°E	42.94'
Kent Co. Mon. (M-8, T6N, R10W)		South	16.04'
Old fence to East is South 16' ±			
On C/L N-S bit. road ±			

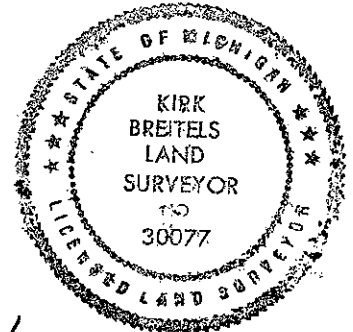

Signed by Kirk Breitels  
Surveyor's Michigan License No. 30077

Date 4/19/96

STATE OF MICHIGAN  
COUNTY OF KENT  
RECEIVED FOR RECORD  
96 JUN -7 AM 8:28  
REG. OF DEEDS  
*Lucy Stand*

**9177**

Register of Deeds Stamp & File Number

A	B	C	D	E	F	G	H	I	J	K	L	M
1												
2	6	5	4	3	2	1						
3												
4	7	8	9	10	11	12						
5												
6	18	17	16	15	14	13						
7												
8	19	20	21	22	23	24						
9												
10	30	29	28	27	26	25						
11												
12	31	32	33	34	35	36						
13												