

# SURVEY & REMONUMENTATION

MAR 03 1998

KENT COUNTY REMONUMENTATION

## LAND CORNER RECORDATION CERTIFICATE Filing Requirement of Act 74, Mich. P.A. 1970

### SECTION

For corners in  
KENT COUNTY  
(County)

Located In: Corner Code #

- |                                    |           |     |
|------------------------------------|-----------|-----|
| 1. Public Land Survey              | T 6N R 9W | B-5 |
|                                    | T R       |     |
|                                    | T R       |     |
|                                    | T R       |     |
|                                    | T R       |     |
| 2. Property Controlling in Section | S T R     |     |
|                                    | S T R     |     |
| 3. Miscellaneous Property in Sec.  | S T R     |     |
|                                    | S T R     |     |

REG. OF DEEDS

*Lucy Bond*

STATE OF MICHIGAN  
COUNTY OF KENT  
RECEIVED FOR RECORD  
97 APR 29 AM 8:20

9794

Register of Deeds Stamp & File Number

4. Lot No. \_\_\_\_\_, Recorded Plat \_\_\_\_\_  
5. Private Claims \_\_\_\_\_

I, Kirk Breitels, in a field survey on Feb. 19 97 do hereby state that under requirements of P.A. 74, Michigan P.A. of 1970, the corner points mentioned in lines 1 and 2 above were in conformance with regulations and rules therefore as required in the current manual of survey instructions of the United States Department of the Interior, Bureau of Land Management or by a decree of a Court of Law and /or that the corner points mentioned in lines 3, 4 and 5 above were in conformance with the rules of the Michigan Board of Land Surveyors or by a Decree of a Court of Law; established, re-established, monumented, recovered, found as expressed below:

NOTE: Not more than 2 corners, all in the same town and range, may be recorded on this certificate.

1	A	B	C	D	E	F	G	H	I	J	K	L	M
2		6		5		4		3		2		1	
3													
4		7		8		9		10		11		12	
5													
6		18		17		16		15		14		13	
7													
8		19		20		21		22		23		24	
9													
10		30		29		28		27		26		25	
11													
12		31		32		33		34		35		36	
13													

A. Description of original monument and accessories and/or subsequent restoration:

- |     |      |               |            |                          |
|-----|------|---------------|------------|--------------------------|
| B-5 | 1830 | GLO           | Mullett    | Set Post                 |
|     | 1965 | Kent Co. Wit. |            | "T" Iron                 |
|     | 1977 | LCRC #1015    | McCombs    | "T" Iron                 |
|     | 1977 | LCRC #1088    | VanKooten  | "T" Iron                 |
|     | 1979 | LCRC #1307    | Nederveld  | "T" Iron                 |
|     | 1982 | LCRC #2716    | Merdzinski | Set Kent County Monument |
|     | 1995 | LCRC #8170    | Breitels   | Kent County Monument     |

The position of this corner was previously approved by the Kent County Remonumentation Peer Group, monumented by John A. Merdzinski on 1/8/82 and was recorded per LCRC #2716

B. Description of corner evidence found and/or method applied in restoring or reestablishing corner:

B-5 Found standard Kent Co. Mon. (Harrison) per witnesses from above LCRC as set by John A. Merdzinski in place of the "T" Iron he found. Said "T" Iron checks with Kent co. Wit. and LCRC's #1015, #1088 & #1307.

<u>LCRC #2716</u>		<u>LCRC #8170</u>
Nail & tag 22" Hickory	West 15.90'	Nail & tag 32" Hickory S90°W 15.87'
Nail & tag 12" Tri. Oak	S45°W 36.70'	Nail & tag 16" Tri. Oak S45°W 36.72'
Nail & tag 10" W. Cherry	South 79.94'	Nail & tag 15" W. Cherry S00°W 79.98'
Nail & tag 4" Apple	N25°E 53.80'	Nail & tag Fence Post N45°W 25.34'
Nail & tag 10" Walnut	N10°W 124.35'	Nail & tag cl. 6" Maples N10°E 125.69'


The selected location is accepted by me and is generally accepted by professional surveyors as the best available evidence of the position of the original corner.

C. Description of monument for corner and accessories established to perpetuate locating the position of the corner:

- |  |               |
|--|---------------|
| B-5 Standard Kent County Monument                  |               |
| Nail & KC Remon. tag N. side 32" Hickory           | S90°W 15.87'  |
| Nail & KC Remon. tag NW side 16" Tri. Oak          | S45°W 36.72'  |
| Nail & KC Remon. tag E. side 15" W. Cherry         | S00°W 79.98'  |
| Nail & KC Remon. tag NE side Util. Pole fence post | N45°W 25.34'  |
| Nail & KC Remon. tag W. side clump 6" Maples       | N10°E 125.69' |
| Steel fence corner post South 2.5' m/l             |               |
| N-S fence on W. side of lane is 16' W.             |               |
| C/L N-S 8' wide farm lane is 6' E.                 |               |

Signed by *Kirk Breitels*  
Surveyor's Michigan License No. 30077

Date 3/27/97

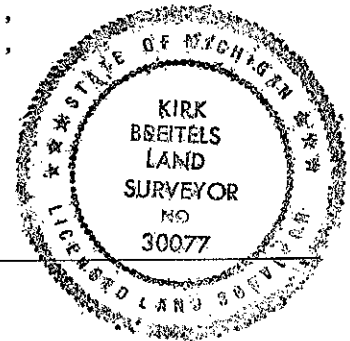

P.A. 345 1990 KENT COUNTY  
PEER APPROVED 3/27/97  
CHAIRMAN *Harry J. Huber*