

SURVEY & REMONUMENTATION

MAR 03 1998

KENT COUNTY REMONUMENTATION

SECTION

LAND CORNER RECORDATION CERTIFICATE
Filing Requirement of Act 74, Mich. P.A. 1970

For corners in
KENT COUNTY

(County)

Located In:

Corner Code #

1. Public Land Survey

T 6N R 9W B-8

T R

T R

T R

2. Property Controlling in Section

S T R

S T R

3. Miscellaneous Property in Sec.

S T R

S T R

4. Lot No. _____, Recorded Plat _____

5. Private Claims _____

STATE OF MICHIGAN
COUNTY OF KENT
RECEIVED FOR RECORD

97 OCT 14 AM 10:31

REG. OF DEEDS

10060

Register of Deeds Stamp & File Number

I, Kirk Breitels, in a field survey on July 14, 1997 do hereby state that under requirements of P.A. 74, Michigan P.A. of 1970, the corner points mentioned in lines 1 and 2 above were in conformance with regulations and rules therefore as required in the current manual of survey instructions of the United States Department of the Interior, Bureau of Land Management or by a decree of a Court of Law and/or Board of Land Surveyors or by a Decree of a Court of Law; established, re-established, monumented, recovered, found as expressed below.

NOTE: Not more than 2 corners, all in the same town and range, may be recorded on this certificate.

	A	B	C	D	E	F	G	H	I	J	K	L	M
1													
2	6		5		4		3		2		1		
3													
4	7		8		9		10		11		12		
5													
6	18		17		16		15		14		13		
7													
8	19		20		21		22		23		24		
9													
10	30		29		28		27		26		25		
11													
12	31		32		33		34		35		36		
13													

A. Description of original monument and accessories and/or subsequent restoration:

- B-8 1830---GLO---Not Set
- Williams & Works---No information
- Kent Co. Wits.---No information
- 1976---Survey---Consumers Power Co.---Intersection of 1/4 lines
- 1979---LCRC #1266---Bonnema---Rerod w/CP Co. cap
- 16" Oak E 33.27' 22" Oak N 37.45' 14" Oak W 17.04'
- Fence corner post 12' E. and 6' S.

P.A. 345 1990 KENT COUNTY
PEER APPROVED 7/24/97
CHAIRMAN [Signature]

B. Description of corner evidence found and/or method applied in restoring or reestablishing corner:


- B-8 Found Rerod with broken cap that fits following witnesses:
- C/L 24" Oak E 33.6' C/L 27" Oak N 37.1' C/L 18" Oak W 17'
- Fd. fence corner post 12' E. and 6' S.

Rerod is 0.3' S. and 0.4' W. of intersection of 1/4 lines and agrees with measurements of others.

The Rerod is accepted by me and is generally accepted by professional surveyors as the best available evidence of the position of the corner.

C. Description of monument for corner and accessories established to perpetuate locating the position of the corner:

- B-8 Set Standard Kent Co. Monument (Harrison) in place of the Rerod
- Nail & KC Remon. tag N. side 18" Oak S75°W 16.95'
- Nail & KC Remon. tag W. side 27" Oak N10°E 37.11'
- Nail & KC Remon. tag N. side 24" Oak S90°E 33.64'
- Nail & KC Remon. tag E. side 24" Maple S10°W 48.66'

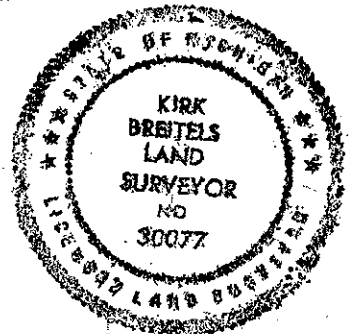

Signed by [Signature]
Surveyor's Michigan License No. 30077

Date 9/25/97