

MAR 09 1998

KENT COUNTY REMONUMENTATION

SECTION

LAND CORNER RECORDATION CERTIFICATE  
Filing Requirement of Act 74, Mich. P.A. 1970

For corners in  
KENT COUNTY  
(County)

Located In:	Corner Code #
T 6N R 9W	B-9
T R	
T R	
T R	
T R	
S T R	
S T R	
S T R	
S T R	

- 1. Public Land Survey
- 2. Property Controlling in Section
- 3. Miscellaneous Property in Sec.

REG. OF DEEDS

*Lucy Bond*

97 APR 29 AM 8:20

STATE OF MICHIGAN  
COUNTY OF KENT  
RECEIVED FOR RECORD

9796

Register of Deeds Stamp & File Number

- 4. Lot No. \_\_\_\_\_, Recorded Plat \_\_\_\_\_
- 5. Private Claims \_\_\_\_\_

I, Kirk Breitels, in a field survey on Jan. 9, 1997 do hereby state that under requirements of P.A. 74, Michigan P.A. of 1970, the corner points mentioned in lines 1 and 2 above were in conformance with regulations and rules therefore as required in the current manual of survey instructions of the United States Department of the Interior, Bureau of Land Management or by a decree of a Court of Law and /or that the corner points mentioned in lines 3, 4 and 5 above were in conformance with the rules of the Michigan Board of Land Surveyors or by a Decree of a Court of Law, established, re-established, monumented, recovered, found as expressed below:

NOTE: Not more than 2 corners, all in the same town and range, may be recorded on this certificate.

	A	B	C	D	E	F	G	H	I	J	K	L	M
1													
2	6	5	4	3	2	1							
3													
4	7	8	9	10	11	12							
5													
6	18	17	16	15	14	13							
7													
8	19	20	21	22	23	24							
9	●												
10	30	29	28	27	26	25							
11													
12	31	32	33	34	35	36							
13													

A. Description of original monument and accessories and/or subsequent restoration:

B-9	1830	GLO	Mullett	Set Post
	1944	Kent Co. Wit.		No desc. - witnesses given
	1979	LCRC #1266	Bonnema	1" Solid Bar
	1981	LCRC #2373	Bueche	Set Kent County Monument
	1995	LCRC #8172	Breitels	Kent County Monument

The position of this corner was previously approved by the Kent County Remonumentation Peer Group, monumented by John C. Bueche on 11/25/81 and was recorded per LCRC #2373.

B. Description of corner evidence found and/or method applied in restoring or reestablishing corner:

B-9 Found standard Kent Co. Mon. (Harrison) per witnesses from above LCRC as set by John C. Bueche in place of the 1" Solid Bar he found. Said 1" Solid Bar checks with Kent Co. Wit. and LCRC #1266.

LCRC #2373

Remon. tag Tri. 8" Box Elder	N40°W	40.15'
Remon. tag double 10" Elm	N05°E	52.33'
Remon. tag 28" Maple	N65°E	92.33'
Remon. tag 10" Apple	S25°E	24.83'
Remon. tag Power Pole	S40°W	55.67'

LCRC #8172


Nail & tag dbl. 18" Elm	N05°E	52.47'
Nail & tag 36" Maple	N65°E	91.98'
Nail & tag P. Pole	S40°W	55.67'
Nail & tag 10" Apple	S50°E	31.00'
Nail & tag 12" Apple	S50°E	58.06'

The selected location is accepted by me and is generally accepted by professional surveyors as the best available evidence of the position of the original corner.

C. Description of monument for corner and accessories established to perpetuate locating the position of the corner:

B-9 Standard Kent County Monument

KC Remon. tag & nail E. side double 18" Elm	N05°E	52.47'
KC Remon. tag & nail S. side 36" Maple	N65°E	91.98'
KC Remon. tag & nail E. side Power Pole	S40°W	55.67'
KC Remon. tag & nail W. side 10" Apple	S15°W	31.00'
KC Remon. tag & nail NE side 12" Apple	S50°E	58.06'
C/L blktp. E & W is North 2.8' m/1		

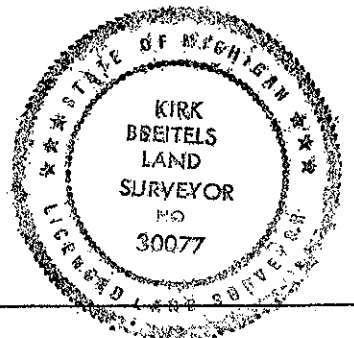

Signed by *Kirk Breitels*  
Surveyor's Michigan License No. 30077

Date 3/27/97

P.A. 345 1990 KENT COUNTY

PEER APPROVED 3/27/97  
CHAIRMAN *Harry Huber*