

**KENT COUNTY REMONUMENTATION  
LAND CORNER RECORDATION CERTIFICATE**  
Filing Requirement of Act 74, Mich. P.A. 1970

STATE OF MICHIGAN  
COUNTY OF KENT  
RECEIVED FOR RECORD

93 DEC 20 AM 11:57

For corners in

Kent

(County)

Located In:

Corner Code :#

- |                                    |                         |                   |
|------------------------------------|-------------------------|-------------------|
| 1. Public Land Survey              | T <u>6N</u> R <u>9W</u> | <u>B-10</u>       |
|                                    | T _____ R _____         | <u>Center</u>     |
|                                    | T _____ R _____         | <u>Section 30</u> |
|                                    | T _____ R _____         | <u>Lowell</u>     |
| 2. Property Controlling in Section | S _____ T _____ R _____ | <u>Township</u>   |
|                                    | S _____ T _____ R _____ |                   |
| 3. Miscellaneous Property in Sec.  | S _____ T _____ R _____ |                   |
|                                    | S _____ T _____ R _____ |                   |

*Thomas W. Chettleburgh*  
REG. OF DEEDS

**6858**

Register of Deeds Stamp & File Number

4. Lot No. \_\_\_\_\_, Recorded Plat \_\_\_\_\_
5. Private Claims \_\_\_\_\_

	A	B	C	D	E	F	G	H	I	J	K	L	M
2	6	5	4	3	2	1							
3													
4	7	8	9	10	11	12							
5													
6	18	17	16	15	14	13							
7													
8	19	20	21	22	23	24							
9													
10		29	28	27	26	25							
11													
12	31	32	33	34	35	36							
13													

Thomas W.

I, Chettleburgh, in a field survey on November 30, 19 93, do hereby certify that under requirements of P.A. 74, Michigan P.A. of 1970, the corner points mentioned in lines 1 and 2 above were in conformance with regulations and rules therefore as required in the current manual of survey instructions of the United States Department of the Interior, Bureau of Land Management or by a decree of a Court of Law and/or that the corner points mentioned in lines 3, 4 and 5 above were in conformance with the rules of the Michigan Board of Land Surveyors or by a Decree of a Court of Law; established, re-established, monumented, re-monumented, recovered, found as expressed below:

NOTE: Not more than 4 corners, all in the same town and range, may be recorded on this certificate.

A. Description of original monument and accessories and/or subsequent restoration:  
No record of corner during research.

B. Description of corner evidence found and/or method applied in restoring or reestablishing corner:

Hold intersection of 1/4 lines for corner


North 1/4 corner Section 30 (B-9)	N00°23'42"E	2645.54'
East 1/4 corner Section 30 (C-10)	S89°58'57"E	2642.15'
South 1/4 corner Section 30 (B-11)	S00°23'42"W	2635.23'
West 1/4 corner Section 30 (A-10)	N89°58'57"W	2544.95'

Set 4"X30" Harrison Monument at intersection of 1/4 lines

C. Description of monument for corner and accessories established to perpetuate locating the position of the corner:

4"X30" Harrison Monument

Centerline West end Concrete Headwall	N90°W	50.68'
Nail/Tag N side 7" Maple	S85°W	32.95'
Nail/Tag NW side 4" Maple	S65°W	27.70'
Nail/Tag E side 8" Maple°	S10°E	28.95'
Corner 2 1/2"X 2 1/2" Steel Angle Fence Post	S55°E	5.34'
E - W R.O.W. Fence Line I-96	South	3.0'
Fence Line to South	East	4.4'

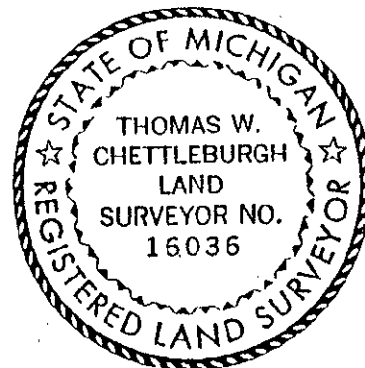

Signed by *Thomas W. Chettleburgh*

Date December 20, 1993

Surveyor's Michigan License No. 16036