

MAR 03 1998

KENT COUNTY REMONUMENTATION

SECTION

LAND CORNER RECORDATION CERTIFICATE
Filing Requirement of Act 74, Mich. P.A. 1970

For corners in
KENT COUNTY

(County)

Located In:

Corner Code #

1. Public Land Survey	T 6N R 9W	B-11
	T R	
	T R	
	T R	
2. Property Controlling in Section	S T R	
	S T R	
3. Miscellaneous Property in Sec.	S T R	
	S T R	

REG. OF DEEDS

Lucy Bond

97 JUN -3 AM 8:11

STATE OF MICHIGAN
COUNTY OF KENT
RECEIVED FOR RECORD

9988

Register of Deeds Stamp & File Number

4. Lot No. _____, Recorded Plat _____
5. Private Claims _____

A	B	C	D	E	F	G	H	I	J	K	L	M
1												
2	6	5	4	3	2	1						
3												
4	7	8	9	10	11	12						
5												
6	18	17	16	15	14	13						
7												
8	19	20	21	22	23	24						
9												
10	30	29	28	27	26	25						
11	●											
12	31	32	33	34	35	36						
13												

I, Kirk Breitels, in a field survey on May 6, 1997 do hereby state that under requirements of P.A. 74, Michigan P.A. of 1970, the corner points mentioned in lines 1 and 2 above were in conformance with regulations and rules therefore as required in the current manual of survey instructions of the United States Department of the Interior, Bureau of Land Management or by a decree of a Court of Law and for that the corner points mentioned in lines 3, 4 and 5 above were in conformance with the rules of the Michigan Board of Land Surveyors or by a Decree of a Court of Law; established, re-established, monumented, recovered, found as expressed below:

NOTE: Not more than 2 corners, all in the same town and range, may be recorded on this certificate.

A. Description of original monument and accessories and/or subsequent restoration:

B-11	1830	GLO	Mullett	Set Post
	1964	Kent Co. Wit.		Conc. Monument
	1976	LCRC #940	Merdzinski	Conc. Mon. in mon. box
	1980	LCRC #1404	Merdzinski	Conc. Mon. in mon. box
	1981	LCRC #2255	Merdzinski	Set Kent County Monument in mon. box
	1995	LCRC #8173	Breitels	Kent County Monument

The position of this corner was previously approved by the Kent County Remonumentation Peer Group, monumented by John A. Merdzinski on 8/14/81 and was recorded per LCRC #2255

B. Description of corner evidence found and/or method applied in restoring or reestablishing corner:

B-11 Found standard Kent Co. Mon. (Harrison) per witnesses from above LCRC as set by John A. Merdzinski in place of the Conc. Monument he found inside a mon. box. Said Conc. Monument checks with Kent Co. Wit. and LCRC's #940 and #1404.

LCRC #2255

LCRC #8173


Nail & tag 14" Basswood	S05°E	24.55'	Nail & tag Tri. 40" Basswood	S35°W	32.22'
Nail & tag Tri. 24" Basswood	S35°W	31.67'	Nail & tag 36" dead Maple	N50°W	38.18'
Nail & tag 36" Maple	N50°W	38.18'	Nail & tag 36" Walnut	S70°W	77.05'
Nail & tag cor. fence post	North	27.6'	Nail & tag 15" Maple	N65°E	41.17'
Nail & tag Tw. Chinese Elm	N55°E	45.34'	Nail & tag 30" Tw. Basswood	S00°E	25.38'
Nail & tag 30" Walnut	S70°W	77.00'	Nail & tag 32" Maple	N75°W	98.50'

The selected location is accepted by me and is generally accepted by professional surveyors as the best available evidence of the position of the original corner.

C. Description of monument for corner and accessories established to perpetuate locating the position of the corner:

B-11 Standard Kent County Monument

Nail & KC Remon. tag E. side Tri. 24" Basswood	S35°W	32.22'
Nail & KC Remon. tag SW side 36" dead Maple	N50°W	38.18'
Nail & KC Remon. tag N. side 36" Walnut	S70°W	77.05'
Nail & KC Remon. tag S. side 15" Maple	N65°E	41.17'
Nail & KC Remon. tag E. side 20" Tw. Basswood	S00°E	25.38'
Nail & KC Remon. tag S. side 32" Maple	N75°W	98.50'
C/L paved road East & West is South 1' m/1		

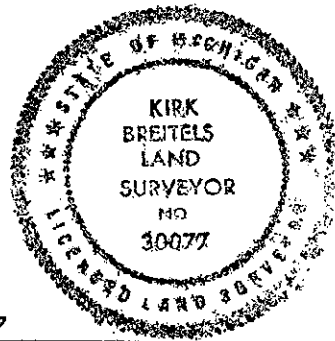

Signed by *Kirk Breitels*
Surveyor's Michigan License No. 30077

Date 5/22/97

P.A. 345 1999 KENT COUNTY

PEER APPROVED 5/22/97

CHAIRMAN *Frank Hubers*