

SURVEY & REMONUMENTATION

MAR 03 1998

KENT COUNTY REMONUMENTATION

SECTION

LAND CORNER RECORDATION CERTIFICATE
Filing Requirement of Act 74, Mich. P.A. 1970

For corners in
KENT COUNTY

(County)

Located in:

Corner Code #

- | | | |
|------------------------------------|-----------|-----|
| 1. Public Land Survey | T 6N R 9W | C-2 |
| | T R | |
| | T R | |
| | T R | |
| 2. Property Controlling in Section | S T R | |
| | S T R | |
| 3. Miscellaneous Property in Sec. | S T R | |
| | S T R | |

REC. OF DEEDS

Lucy Bond

97 APR 29 AM 8:21

STATE OF MICHIGAN
COUNTY OF KENT
RECEIVED FOR RECORD

9799

Register of Deeds Stamp & File Number

4. Lot No. _____, Recorded Plat _____
5. Private Claims _____

I, Kirk Breitels, in a field survey on Feb. 20, 1997 do hereby state that under requirements of P.A. 74, Michigan P.A. of 1970, the corner points mentioned in lines 1 and 2 above were in conformance with regulations and rules therefore as required in the current manual of survey instructions of the United States Department of the Interior, Bureau of Land Management or by a decree of a Court of Law and/or that the corner points mentioned in lines 3, 4 and 5 above were in conformance with the rules of the Michigan Board of Land Surveyors or by a Decree of a Court of Law; established, re-established, monumented, recovered, found as expressed below:

NOTE: Not more than 2 corners, all in the same town and range, may be recorded on this certificate.

A	B	C	D	E	F	G	H	I	J	K	L	M
1												
2	6	5		4		3		2		1		
3												
4	7	8		9		10		11		12		
5												
6	18	17		16		15		14		13		
7												
8	19	20		21		22		23		24		
9												
10	30	29		28		27		26		25		
11												
12	31	32		33		34		35		36		
13												

A. Description of original monument and accessories and/or subsequent restoration:

- | | | | | |
|-----|------|---------------|-----------|--------------------------|
| C-2 | 1830 | GLO | Mullett | Set Post |
| | 1970 | Kent Co. Wit. | | 3/4" Iron |
| | 1972 | LCRC #114 | Spicer | 1 1/2" Iron |
| | 1981 | LCRC #2097 | VanKooten | "T" Iron |
| | 1988 | LCRC #4914 | Marschall | Set Kent County Monument |
| | 1995 | LCRC #8174 | Breitels | Kent County Monument |

The position of this corner was previously approved by the Kent County Remonumentation Peer Group, monumented by Chris Marschall on 11/2/88 and was recorded per LCRC #4914.

B. Description of corner evidence found and/or method applied in restoring or reestablishing corner:

C-2 Found standard Kent Co. Mon. (Harrison) per witnesses from above LCRC as set by Chris Marschall in place of the "T" Iron he found. Said "T" Iron checks with Ken Co. Wits. and LCRC's #114 & #2097.

- | | | | |
|---------------------|-------------------------|---------------------|----------------------------|
| LCRC #4914 | PK-C/L Parnell E 42.05' | LCRC #8174 | PK-C/L Parnell East 42.20' |
| Nail & tag P. Pole | N03°E 179.25' | Nail & tag P. Pole | N03°E 179.31' |
| Nail & tag 18" Oak | N73°E 95.47' | Nail & tag 18" Oak | N73°E 95.53' |
| Nail & tag 32" Oak | N30°W 166.66' | Nail & tag 32" Oak | N30°W 166.58' |
| Nail & tag P. Pole | S18°E 33.87' | Nail & tag P. Pole | S18°E 33.87' |
| NE cor. hse. siding | N47°W 171.54' | NE cor. hse. siding | N47°W 171.54' |


The selected location is accepted by me and is generally accepted by professional surveyors as the best available evidence of the position of the original corner.

C. Description of monument for corner and accessories established to perpetuate locating the position of the corner:

C-2 Standard Kent County Monument in gravel driveway

- Nail & KC Remon. tag W. side P. Pole
- Nail & KC Remon. tag N. side 20" Oak
- Nail & KC Remon. tag NE side 34" Oak
- Nail & KC Remon. tag SW side P. Pole
- Nail & KC Remon. tag top of guard rail post
- PK Nail in C/L Parnell Ave.
- NE corner house #1585 (siding)
- C/L grav. dr. to house #1585 is NE'ly 4'±

- N03°E 179.31'
- N73°E 95.53'
- N30°W 166.58'
- S18°E 33.87'
- S85°W 14.50'
- East 42.09'
- N47°W 171.54'

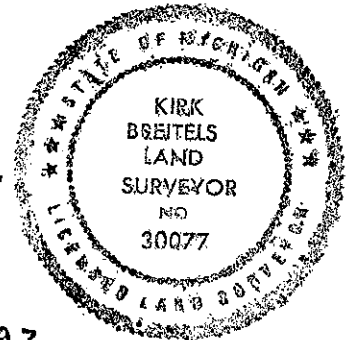

Signed by *Kirk Breitels*
Surveyor's Michigan License No. 30077

Date 3/27/97

P.A. 345 1990 KENT COUNTY

PEER APPROVED 3/27/97

CHAIRMAN *Harold Hubert*

FORM APPROVED BY MICHIGAN STATE BOARD OF PROFESSIONAL SURVEYORS, JAN. 28, 1971
REVISED MAY 14, 1975
REVISED JAN., 1983
REVISED OCT., 1985