

**SURVEY & REMONUMENTATION**

MAR 03 1998

KENT COUNTY REMONUMENTATION

**SECTION**

**LAND CORNER RECORDATION CERTIFICATE**  
Filing Requirement of Act 74, Mich. P.A. 1970

For corners in

KENT COUNTY

(County)

Located In:

Corner Code #

1. Public Land Survey

T 6N R 9W

C-3

T R

T R

T R

T R

2. Property Controlling in Section

S T R

S T R

3. Miscellaneous Property in Sec.

S T R

S T R

REG. OF DEEDS  
97 APR 29 AM 8:21  
STATE OF MICHIGAN  
COUNTY OF KENT  
RECEIVED FOR RECORD

9800


Register of Deeds Stamp & File Number

4. Lot No. \_\_\_\_\_, Recorded Plat \_\_\_\_\_

5. Private Claims \_\_\_\_\_

I, Kirk Breitels, in a field survey on Jan. 10 1997 do hereby state that under requirements of P.A. 74, Michigan P.A. of 1970, the corner points mentioned in lines 1 and 2 above were in conformance with regulations and rules therefore as required in the current manual of survey instructions of the United States Department of the Interior, Bureau of Land Management or by a decree of a Court of Law and /or that the corner points mentioned in lines 3, 4 and 5 above were in conformance with the rules of the Michigan Board of Land Surveyors or by a Decree of a Court of Law; established, re-established, monumented, recovered, found as expressed below:

NOTE: Not more than 2 corners, all in the same town and range, may be recorded on this certificate.

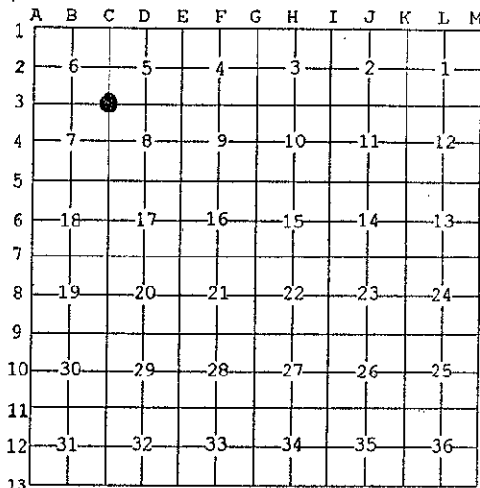

A. Description of original monument and accessories and/or subsequent restoration:

C-3	1830	GLO	Mullett	Set Post
	1970	Kent Co. Wit.		Iron
	1971	LCRC #103	Chambers	1/2" Iron
	1981	LCRC #2097	VanKooten	Monument in mon. box
	1981	LCRC #2258	Merdzinski	Set Kent County Monument in mon. box
	1995	LCRC #8175	Breitels	Kent County Monument

The position of this corner was previously approved by the Kent County Remonumentation Peer Group, monumented by John A. Merdzinski on 6/11/81 and was recorded per LCRC #2258

B. Description of corner evidence found and/or method applied in restoring or reestablishing corner:

C-3 Found standard Kent Co. Mon. (Harrison) per witnesses from above LCRC as set by John A. Merdzinski in place of the 1/2" Iron he found inside a mon. box. Said Iron checks with Kent Co. Wit. and LCRC's #103 and #2097.

LCRC #2258

LCRC #8175


Nail & tag 12" W. Cherry	N85°W	54.43'		same witnesses
Nail & tag 26" Pine	N30°W	98.86'	SW cor. hse. fnd.	as LCRC #2258
Nail & tag top wood post	East	33.55'	N55°W 120.47'	except wood post
Nail & tag 16" Oak	S10°W	150.98'		
Nail & tag 14" W. Cherry	S30°E	73.20'		

The selected location is accepted by me and is generally accepted by professional surveyors as the best available evidence of the position of the original corner.

C. Description of monument for corner and accessories established to perpetuate locating the position of the corner:

C-3 Standard Kent County Monument in Mon. Box

Nail & KC Remon. tag N. side 24" W. Cherry	N85°W	54.54'
Nail & KC Remon. tag NE side 30" Pine	N30°W	98.93'
Nail & KC Remon. tag E. side 22" Oak	S10°W	151.18'
Nail & KC Remon. tag N. side 15" Cherry	S60°E	57.76'
SW cor. foundation to hse. #1979	N55°W	120.47'
Approx. C/L Settewood North 279' m/l		

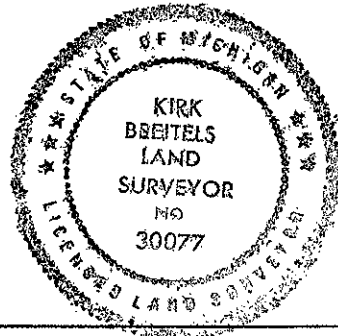

Signed by Kirk Breitels  
Surveyor's Michigan License No. 30077

Date 3/27/97

P.A. 345 1990 KENT COUNTY

PEER APPROVED 3/27/97

CHAIRMAN Harry Huber