

**SURVEY & REMONUMENTATION**

MAR 03 1998

**SECTION**

**KENT COUNTY REMONUMENTATION**

**LAND CORNER RECORDATION CERTIFICATE**  
Filing Requirement of Act 74, Mich. P.A. 1970

For corners in  
**KENT COUNTY**  
(County)

Located In: Corner Code #

1. Public Land Survey	T <u>6N</u> R <u>9W</u>	C-8
	T _____ R _____	_____
	T _____ R _____	_____
	T _____ R _____	_____
2. Property Controlling in Section	S _____ T _____ R _____	_____
	S _____ T _____ R _____	_____
3. Miscellaneous Property in Sec.	S _____ T _____ R _____	_____
	S _____ T _____ R _____	_____

STATE OF MICHIGAN  
COUNTY OF KENT  
RECEIVED FOR RECORD  
97 APR 29 AM 8:21  
REG. OF DEEDS  
*Lucy Standa*

9806

Register of Deeds Stamp & File Number

4. Lot No. \_\_\_\_\_, Recorded Plat \_\_\_\_\_  
5. Private Claims \_\_\_\_\_

I, Kirk Breitels, in a field survey on Jan. 23, 1997 do hereby state that under requirements of P.A. 74, Michigan P.A. of 1970, the corner points mentioned in lines 1 and 2 above were in conformance with regulations and rules therefore as required in the current manual of survey instructions of the United States Department of the Interior, Bureau of Land Management or by a decree of a Court of Law and /or that the corner points mentioned in lines 3, 4 and 5 above were in conformance with the rules of the Michigan Board of Land Surveyors or by a Decree of a Court of Law; established, re-established, monumented, recovered, found as expressed below:

NOTE: Not more than 2 corners, all in the same town and range, may be recorded on this certificate.

	A	B	C	D	E	F	G	H	I	J	K	L	M
1													
2	6		5		4		3		2		1		
3													
4	7		8		9		10		11		12		
5													
6	18		17		16		15		14		13		
7													
8	19		20		21		22		23		24		
9													
10	30		29		28		27		26		25		
11													
12	31		32		33		34		35		36		
13													

A. Description of original monument and accessories and/or subsequent restoration:

C-8	1830	GLO	Mullett	Set Post
	1963	Kent Co. Wit.		Iron
	1977	LCRC #1017	McCombs	1" Pipe
	1985	LCRC #4203	Rosema	Set Kent County Monument
	1995	LCRC #8180	Breitels	Kent County Monument

The position of this corner was previously approved by the Kent County Remonumentation Peer Group, monumented by Maurice J. Rosema on 5/23/85 and was recorded per LCRC #4203

B. Description of corner evidence found and/or method applied in restoring or reestablishing corner:


C-8 Found standard Kent Co. Mon. (Harrison) per witnesses from above LCRC as found by Maurice J. Rosema. Said Monument checks with Kent Co. Wit. and LCRC #1066.

<u>LCRC #4203</u>		<u>LCRC #8180</u>	
Nail & tag Tw. 15" Maple	N20°E 20.38'	Nail & tag Tw. 22" Maple	N20°E 20.40'
Nail & tag 18" Beech	S20°W 23.00'	Nail & tag 24" Beech	S20°W 23.01'
Nail & tag 15" Oak	N90°W 30.33'	Nail & tag 20" Oak	N90°W 30.33'
Nail & tag 15" Maple	N90°E 30.10'	Nail & tag 22" Maple	N90°E 30.17'
Nail & tag 18" Ash	N27°W 37.26'	Nail & tag 26" Ash	N27°W 37.29'

The selected location is accepted by me and is generally accepted by professional surveyors as the best available evidence of the position of the original corner.

C. Description of monument for corner and accessories established to perpetuate locating the position of the corner:

C-8 Standard Kent County Monument			
Nail & KC Remon. tag W. side Tw. 22" Maple	N20°E	20.40'	
Nail & KC Remon. tag W. side 24" Beech	S20°W	23.01'	
Nail & KC Remon. tag N. side 20" Oak	N90°W	30.33'	
Nail & KC Remon. tag S. side 22" Maple	N90°E	30.17'	
Nail & KC Remon. tag SW side 26" Ash	N27°W	37.29'	

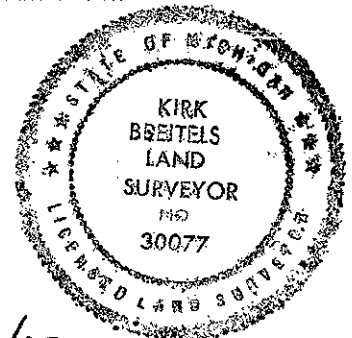

Signed by *Kirk Breitels*  
Surveyor's Michigan License No. 30077

Date 3/27/97

P.A. 345 1990 KENT COUNTY  
PEER APPROVED 3/27/97  
CHAIRMAN *Harry Henslee*