

SURVEY & REMONUMENTATION

MAR 03 1998

KENT COUNTY REMONUMENTATION

SECTION

LAND CORNER RECORDATION CERTIFICATE
Filing Requirement of Act 74, Mich. P.A. 1970

For corners in

KENT COUNTY

(County)

Located In:

Corner Code #

1. Public Land Survey	T <u>6</u> N	R <u>9</u> W	D-1
	T _____	R _____	_____
	T _____	R _____	_____
	T _____	R _____	_____
2. Property Controlling in Section	S _____	T _____	R _____
	S _____	T _____	R _____
3. Miscellaneous Property in Sec.	S _____	T _____	R _____
	S _____	T _____	R _____

STATE OF MICHIGAN
 COUNTY OF KENT
 RECEIVED FOR RECORD
 97 JUN -3 AM 8:11
 REG. OF DEEDS
Lucy J. Bond

9989

Register of Deeds Stamp & File Number

4. Lot No. _____, Recorded Plat _____
 5. Private Claims _____

I, Kirk Breitels, in a field survey on May 13, 1997 do hereby state that under requirements of P.A. 74, Michigan P.A. of 1970, the corner points mentioned in lines 1 and 2 above were in conformance with regulations and rules therefore as required in the current manual of survey instructions of the United States Department of the Interior, Bureau of Land Management or by a decree of a Court of Law and/or that the corner points mentioned in lines 3, 4 and 5 above were in conformance with the rules of the Michigan Board of Land Surveyors or by a Decree of a Court of Law, established, re-established, monumented, recovered, found as expressed below:

NOTE: Not more than 2 corners, all in the same town and range, may be recorded on this certificate.

A	B	C	D	E	F	G	H	I	J	K	L	M
1												
2	6		5		4		3		2		1	
3												
4	7		8		9		10		11		12	
5												
6	18		17		16		15		14		13	
7												
8	19		20		21		22		23		24	
9												
10	30		29		28		27		26		25	
11												
12	31		32		33		34		35		36	
13												

A. Description of original monument and accessories and/or subsequent restoration:

D-1	1830	GLO	Mullett	Not Set
	1971	Kent Co. Wit.		3/4" Iron
	1985	LCRC #4163	Rosema	Set Kent County Monument
	1991	LCRC #5856	Unema	Kent County Monument

The position of this corner was previously approved by the Kent County Remonumentation Peer Group, monumented by Maurice J. Rosema on 4/1/85 and was recorded per LCRC #4163

B. Description of corner evidence found and/or method applied in restoring or reestablishing corner:


D-1 Found PK Nail; 0.2'± from corner per above LCRC's. SET standard Kent Co. Mon. (Harrison) on Twp. line, 75.77' West of D-13, T7N, R9W at same location per LCRC #5856 and LCRC #4163 for monument as set by Maurice J. Rosema on Twp. line in place of the 3/4" Iron he found. Said Iron checks with Kent Co. Wit.

LCRC #4163		LCRC #5856	
Nail & tag 12" Oak	S08°E 37.88'	Nail & tag 14" Oak	S11°E 37.91'
Nail & tag 8" Oak	S41°W 48.23'	Nail & tag 10" Oak	S35°W 48.25'
Nail & tag 6" Pine	N03°E 38.56'	Nail & tag 8" Oak	N81°E 58.67'
Nail & tag Tw. 8" Oak	S51°E 45.12'	Nail & tag 10" Pine	N04°W 38.55'
Nail & tag 6" Oak	N86°E 58.67'	Nail & tag 8" Twin Oak	S51°E 45.13'
KC Mon. (D-13, 7-9)	East 75.85'	KC Mon. (D-13, 7-9)	East 75.77'

The selected location is accepted by me and is generally accepted by professional surveyors as the best available evidence of the position of the corner.

C. Description of monument for corner and accessories established to perpetuate locating the position of the corner:

D-1	Standard Kent County Monument		
	Nail & KC Remon. tag NW side 10" Oak	S35°W	48.25'
	Nail & KC Remon. tag E. side 12" Pine	N04°W	38.57'
	Kent Co. Mon. (D-13, T7N, R9W)	East	75.77'
	Nail & KC Remon. tag W. side 20" Oak	S00°E	36.78'
	Nail & KC Remon. tag SW side 14" Oak	S30°E	53.71'
	Nail & KC Remon. tag N. side P. Pole	N75°E	77.80'
	On approx. C/L E-W asphalt road		

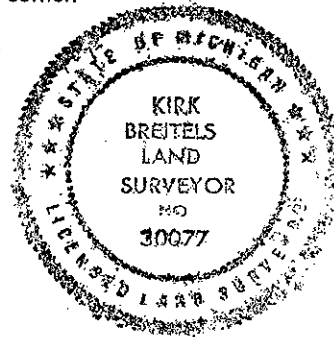

Signed by *Kirk Breitels*

Date 5/22/97

Surveyor's Michigan License No. 30077

P.A. 345 1990 KENT COUNTY

PEER APPROVED 5/22/97

CHAIRMAN *Harry Huber*