

**SURVEY & REMONUMENTATION**

MAR 03 1998

**KENT COUNTY REMONUMENTATION**

**SECTION**

**LAND CORNER RECORDATION CERTIFICATE  
Filing Requirement of Act 74, Mich. P.A. 1970**

For corners in  
**KENT COUNTY**

Located In: Corner Code #

(County)			
1. Public Land Survey	T 6N R 9W	D-2	
	T R		
	T R		
	T R		
2. Property Controlling in Section	S T R		
	S T R		
3. Miscellaneous Property in Sec.	S T R		
	S T R		

REG. OF DEEDS  
 STATE OF MICHIGAN  
 COUNTY OF KENT  
 RECEIVED FOR RECORD  
 97 OCT 14 AM 10:31  
 10062  
 Register of Deeds Stamp & File Number

4. Lot No. \_\_\_\_\_, Recorded Plat \_\_\_\_\_  
 5. Private Claims \_\_\_\_\_

I, Kirk Breitels, in a field survey on July 28, 1997 do hereby state that under requirements of P.A. 74, Michigan P.A. of 1970, the corner points mentioned in lines 1 and 2 above were in conformance with regulations and rules therefore as required in the current manual of survey instructions of the United States Department of the Interior, Bureau of Land Management or by a decree of a Court of Law and /or that the corner points mentioned in lines 3, 4 and 5 above were in conformance with the rules of the Michigan Board of Land Surveyors or by a Decree of a Court of Law; established, re-established, monumented, recovered, found as expressed below:

NOTE: Not more than 2 corners, all in the same town and range, may be recorded on this certificate.

A	B	C	D	E	F	G	H	I	J	K	L	M
1												
2	6		5		4		3		2		1	
3												
4	7		8		9		10		11		12	
5												
6	18		17		16		15		14		13	
7												
8	19		20		21		22		23		24	
9												
10	30		29		28		27		26		25	
11												
12	31		32		33		34		35		36	
13												

**A. Description of original monument and accessories and/or subsequent restoration:**

- D-2 1830---GLO---Not Set
- 1947-48---Williams & Works---Old fence post - 2' South of new fence post
- Kent Co. Wits.---No information
- 1969-72---"Eastgate Woods" plats---MVK---Plats along E-W and N-S 1/4 lines.

(Conc. Mon. @ C 1/4 per MVK notes)

P.A. 345 1990 KENT COUNTY

PEER APPROVED

CHAIRMAN Darryl Huber

**B. Description of corner evidence found and/or method applied in restoring or reestablishing corner:**


- D-2 Found Concrete Monument on East side of fence corner post for fences to North-South and West.

Concrete Monument is 0.3' E. and 0.3' S. of intersection of 1/4 lines and fits section information by MVK ±.

The Concrete Monument is accepted by me and is generally accepted by professional surveyors as the best available evidence of the position of the corner.

**C. Description of monument for corner and accessories established to perpetuate locating the position of the corner:**

- D-2 Set Standard Kent Co. Monument (Harrison) in place of the Concrete Monument
- Nail & KC Remon. tag S. side 14" Oak N75°E 26.86'
- Nail & KC Remon. tag NE side 36" Oak S50°E 6.75'
- Nail & KC Remon. tag E. side 27" Oak S00°E 19.11'
- Nail & KC Remon. tag S. side 18" Oak S70°W 39.80'
- Nail & KC Remon. tag W. side 10" Maple N15°E 13.71'
- C/L of corner post for fences N-S-W is West 1'

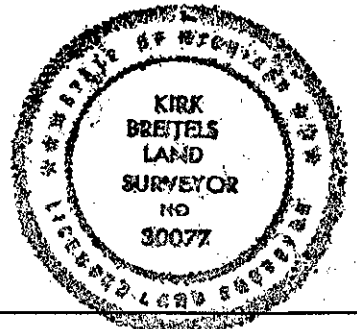

Signed by Kirk Breitels  
 Surveyor's Michigan License No. 30077

Date 9/25/97