

SURVEY & REMONUMENTATION

MAR 03 1998

KENT COUNTY REMONUMENTATION

SECTION

LAND CORNER RECORDATION CERTIFICATE Filing Requirement of Act 74, Mich. P.A. 1970

For corners in
KENT COUNTY
(County)

	Located In:	Corner Code #
1. Public Land Survey	T <u>6N</u> R <u>9W</u>	<u>D-3</u>
	T <u> </u> R <u> </u>	<u> </u>
	T <u> </u> R <u> </u>	<u> </u>
	T <u> </u> R <u> </u>	<u> </u>
2. Property Controlling in Section	S <u> </u> T <u> </u> R <u> </u>	<u> </u>
	S <u> </u> T <u> </u> R <u> </u>	<u> </u>
3. Miscellaneous Property in Sec.	S <u> </u> T <u> </u> R <u> </u>	<u> </u>
	S <u> </u> T <u> </u> R <u> </u>	<u> </u>

STATE OF MICHIGAN
 COUNTY OF KENT
 RECEIVED FOR RECORD
 97 APR 29 AM 8:21
 REG. OF DEEDS
Lucy Standa

9812

Register of Deeds Stamp & File Number

4. Lot No. _____, Recorded Plat _____
 5. Private Claims _____

I, Kirk Breitels, in a field survey on Jan. 14, 1997 do hereby state that under requirements of P.A. 74, Michigan P.A. of 1970, the corner points mentioned in lines 1 and 2 above were in conformance with regulations and rules therefore as required in the current manual of survey instructions of the United States Department of the Interior, Bureau of Land Management or by a decree of a Court of Law and/or that the corner points mentioned in lines 3, 4 and 5 above were in conformance with the rules of the Michigan Board of Land Surveyors or by a Decree of a Court of Law; established, re-established, monumented, recovered, found as expressed below:

NOTE: Not more than 2 corners, all in the same town and range, may be recorded on this certificate.

	A	B	C	D	E	F	G	H	I	J	K	L	M
1													
2	6		5		4		3		2		1		
3				●									
4	7		8		9		10		11		12		
5													
6	10		17		16		15		14		13		
7													
8	19		20		21		22		23		24		
9													
10	30		29		28		27		26		25		
11													
12	31		32		33		34		35		36		
13													

A. Description of original monument and accessories and/or subsequent restoration:

D-3	1830	GLO	Mullett	Set Post
				16" Cherry at corner
	1980	LCRC #1318	VanLaar	3/4" Iron side 24" Cherry
	1981	LCRC #2719	Merdzinski	Set Kent County Monument (0.10' West of corner)
	1995	LCRC #8186	Breitels	Kent County Monument

The position of this corner was previously approved by the Kent County Remonumentation Peer Group, monumented by John A. Merdzinski on 12/30/81 and was recorded per LCRC #2719

B. Description of corner evidence found and/or method applied in restoring or reestablishing corner:

D-3 Found standard Kent Co. Mon. (Harrison) per witnesses from above LCRC as set by John A. Merdzinski in place of the 3/4" Iron he found on the West side of a 24" Cherry. Said Iron checks with Kent Co. Wit. and LCRC #1318.

LCRC #2719		LCRC #8186
Nail & tag 8" Oak	N45°W 33.85'	Nail & tag 15" Oak N45°W 33.98'
Nail & tag 10" Oak	N05°W 42.73'	Nail & tag 15" Oak N05°W 42.82'
Nail & tag 14" Oak	South 21.27'	Nail & tag 18" Oak S00°E 21.10'
Nail & tag 10" Oak	S55°E 8.15'	Nail & tag 14" Oak S55°E 8.10'
Nail & tag 24" W. Cherry East	0.73'	Face of 30" Cherry S90°E 0.5'


The selected location is accepted by me and is generally accepted by professional surveyors as the best available evidence of the position of the original corner.

C. Description of monument for corner and accessories established to perpetuate locating the position of the corner:

D-3 Standard Kent County Monument (0.10' West of corner)

Nail & KC Remon. tag S. side 18" Oak	N45°W	33.98'
Nail & KC Remon. tag W. side 18" Oak	N05°W	42.82'
Nail & KC Remon. tag E. side 20" Oak	S00°E	21.10'
Nail & KC Remon. tag SW side 14" Oak	S55°E	8.10'
Face of 30" W. Cherry	S90°E	0.5'

Remains of fence N & S; Corner is on tree line East.

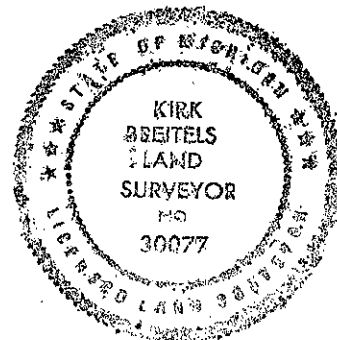

Signed by *Kirk Breitels*
 Surveyor's Michigan License No. 30077

Date 3/27/97