

SURVEY & REMONUMENTATION

MAR 03 1998

KENT COUNTY REMONUMENTATION

SECTION

LAND CORNER RECORDATION CERTIFICATE
Filing Requirement of Act 74, Mich. P.A. 1970

For corners in
KENT COUNTY

Located In: _____ Corner Code # _____

1. Public Land Survey

T	6N	R	9W	D-4
T	_____	R	_____	_____
T	_____	R	_____	_____
T	_____	R	_____	_____
T	_____	R	_____	_____
S	_____	T	_____	_____
S	_____	T	_____	_____
S	_____	T	_____	_____
S	_____	T	_____	_____

2. Property Controlling in Section

3. Miscellaneous Property in Sec.

4. Lot No. _____, Recorded Plat _____
5. Private Claims _____

Kirk Breitels

Aug. 15 1997

I, _____, in a field survey on _____, 19____ do hereby state that under requirements of P.A. 74, Michigan P.A. of 1970, the corner points mentioned in lines 1 and 2 above were in conformance with regulations and rules therefore as required in the current manual of survey instructions of the United States Department of the Interior, Bureau of Land Management or by a decree of a Court of Law and/or that the corner points mentioned in lines 3, 4 and 5 above were in conformance with the rules of the Michigan Board of Land Surveyors or by a Decree of a Court of Law, established, re-established, monumented, recovered, found as expressed below:

NOTE: Not more than 2 corners, all in the same town and range, may be recorded on this certificate.

P.A. 345 1990 KENT COUNTY

PEER APPROVED 8/28/97

CHAIRMAN [Signature]

STATE OF MICHIGAN
COUNTY OF KENT
RECEIVED FOR RECORD

97 NOV 13 PM 1:01

REG. OF DEEDS [Signature]

10271

Register of Deeds Stamp & File Number

A	B	C	D	E	F	G	H	I	J	K	L	M
1												
2	6		5		4		3		2		1	
3												
4	7		8		9		10		11		12	
5												
6	18		17		16		15		14		13	
7												
8	19		20		21		22		23		24	
9												
10	30		29		28		27		26		25	
11												
12	31		32		33		34		35		36	
13												

A. Description of original monument and accessories and/or subsequent restoration:

- D-4 1830---GLO---Not Set
- 1962---Williams & Works---Fence Post at fence line intersection - 5.3' West of true N-S 1/4 line - Set Iron on N-S 1/4 line in C/L Grand River Dr.
- Wit. to Iron in C/L Grand River Dr.:
16" Oak NW 28.0' 20" Maple SW 56.8' 18" Oak W 42.9'
- Kent Co. Wits.---Corner Steel Fence Post
- 1990---Survey---Nederveld---Survey in SW 1/4 show N-S 1/4 line N. of S 1/4 corner.


B. Description of corner evidence found and/or method applied in restoring or reestablishing corner:

D-4 Found "T" Iron in the C/L Grand River Ave. that fits 3 witnesses ± above. Also found "T" Iron at S. R/W of Grand River Dr. on line ± 0.15'. Established C 1/4 corner by extending line from S 1/4 corner through "T" Iron in C/L Grand River Ave. and intersecting it with the true E-W 1/4 line. Found remains of old steel fence post for old fence line to N-S-E to be 2' E. and 4' N. and 2.4' W. of true N-S 1/4 line of C 1/4 established. C 1/4 as established is 4.3' W. of N-S 1/4 line.

The C 1/4 corner as established is accepted by me and is generally accepted by professional surveyors as the best available evidence of the position of the corner.

C. Description of monument for corner and accessories established to perpetuate locating the position of the corner:

- D-4 Set Standard Kent Co. Monument (Harrison) at location as established above.
- Nail & KC Remon. tag SE side 14" Basswood N70°E 29.31'
- Nail & KC Remon. tag NE side 26" Oak S45°E 54.27'
- Nail & KC Remon. tag E. side 30" Oak S10°E 14.52'
- Nail & KC Remon. tag S. side cor. fc. post N80°W 19.48'
- Nail & KC Remon. tag E. side 10" Oak N00°E 25.08'
- New fence corner for fences N-S-E is 4' N. & 19' W.
- Old fence corner for fences N-S-E is 2' N. & 4' E.

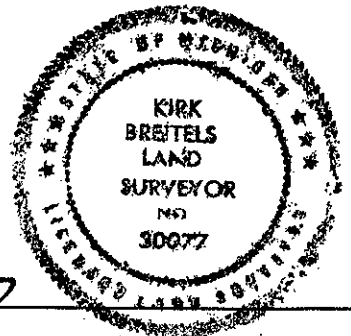

Signed by [Signature]
Surveyor's Michigan License No. 30077

Date 10/30/97