

**SURVEY & REMONUMENTATION**

MAR 03 1998

**KENT COUNTY REMONUMENTATION**

**SECTION**

**LAND CORNER RECORDATION CERTIFICATE**  
Filing Requirement of Act 74, Mich. P.A. 1970

For corners in  
**KENT COUNTY**  
(County)

Located In:	Corner Code #
T 6N R 9W	D-6
T R	
T R	
T R	
S T R	
S T R	
S T R	
S T R	

- 1. Public Land Survey
- 2. Property Controlling in Section
- 3. Miscellaneous Property in Sec.

STATE OF MICHIGAN  
COUNTY OF KENT  
RECEIVED FOR RECORD  
97 OCT 14 AM 10:31  
REG. OF DEEDS  
*Lucy Hand*

**10063**

Register of Deeds Stamp & File Number

- 4. Lot No. \_\_\_\_\_, Recorded Plat \_\_\_\_\_
- 5. Private Claims \_\_\_\_\_

I, Kirk Breitels, in a field survey on July 3, 1997 do hereby state that under requirements of P.A. 74, Michigan P.A. of 1970, the corner points mentioned in lines 1 and 2 above were in conformance with regulations and rules therefore as required in the current manual of survey instructions of the United States Department of the Interior, Bureau of Land Management or by a decree of a Court of Law and/or that the corner points mentioned in lines 3, 4 and 5 above were in conformance with the rules of the Michigan Board of Land Surveyors or by a Decree of a Court of Law; established, re-established, monumented, recovered, found as expressed below:

NOTE: Not more than 2 corners, all in the same town and range, may be recorded on this certificate.

	A	B	C	D	E	F	G	H	I	J	K	L	M
1													
2	6	5	4	3	2	1							
3													
4	7	8	9	10	11	12							
5													
6	18	17	16	15	14	13							
7													
8	19	20	21	22	23	24							
9													
10	30	29	28	27	26	25							
11													
12	31	32	33	34	35	36							
13													

**A. Description of original monument and accessories and/or subsequent restoration:**

- D-6 1830---GLO---Not Set
- 1903-80---Williams & Works---Stone
- 20" Oak NW 13.4' 12" Maple NNW 36.5' 20" Oak SE 41.3'
- 1976---Survey---Medema & VanKooten---"X" on Stone
- 1980---LCRC #1341---Merdzinski---Pointed Stone with "X" cut
- C/L 12" Oak S40°E 20.85' C/L 10" Oak S70°E 24.90'
- C/L 16" Oak N75°W 14.20' C/L 12" Maple N40°W 36.85'

P.A. 345 1990 KENT COUNTY

PEER APPROVED 7/24/97  
CHAIRMAN Harry Burke

**B. Description of corner evidence found and/or method applied in restoring or reestablishing corner:**


- D-6 Found Pointed Stone with "X" cut on top per the following witnesses:  
C/L 14" Oak S40°E 21'± C/L 22" Oak N75°W 14'± C/L 18" Maple N40°W 37'±  
Fence to West is 7'± North  
Fence Corner to North, South, East is 6' East and 2' South

The "X" on the Pointed Stone is 4.2' S. and 2.4' W. of intersection of 1/4 lines and agrees with measurements of others.

The Pointed Stone is accepted by me and is generally accepted by professional surveyors as the best available evidence of the position of the corner.

**C. Description of monument for corner and accessories established to perpetuate locating the position of the corner:**

- D-6 Set Standard Kent Co. Monument (Harrison) in place of the Pointed Stone
- Nail & KC Remon. tag SW side 14" Oak S40°E 20.88'
- Nail & KC Remon. tag NE side 22" Oak S70°E 43.04'
- Nail & KC Remon. tag S. side 22" Oak N75°W 13.86'
- Nail & KC Remon. tag NE side 18" Maple N40°W 37.04'
- Nail & KC Remon. tag W. side 24" Oak N30°E 54.38'

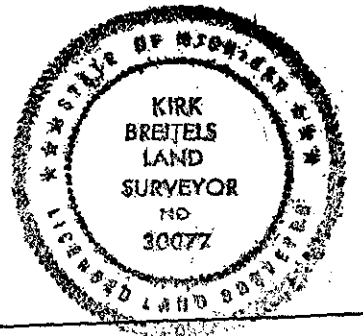

Signed by Kirk Breitels  
Surveyor's Michigan License No. 30077

Date 9/15/97