

SURVEY & REMONUMENTATION

MAR 03 1998

KENT COUNTY REMONUMENTATION

SECTION

LAND CORNER RECORDATION CERTIFICATE
Filing Requirement of Act 74, Mich. P.A. 1970

For corners in
KENT COUNTY
(County)

Located In:	Corner Code #
1. Public Land Survey T 6N R 9W	D-7
T R	
T R	
T R	
T R	
2. Property Controlling in Section S T R	
S T R	
3. Miscellaneous Property in Sec. S T R	
S T R	

STATE OF MICHIGAN
COUNTY OF KENT
RECEIVED FOR RECORD

97 APR 29 AM 8:21

REG. OF DEEDS


9814

Register of Deeds Stamp & File Number

4. Lot No. _____, Recorded Plat _____
5. Private Claims _____

I, Kirk Breitels, in a field survey on Jan. 7, 1997 do hereby state that under requirements of P.A. 74, Michigan P.A. of 1970, the corner points mentioned in lines 1 and 2 above were in conformance with regulations and rules therefore as required in the current manual of survey instructions of the United States Department of the Interior, Bureau of Land Management or by a decree of a Court of Law and/or that the corner points mentioned in lines 3, 4 and 5 above were in conformance with the rules of the Michigan Board of Land Surveyors or by a Decree of a Court of Law; established, re-established, monumented, recovered, found as expressed below:

NOTE: Not more than 2 corners, all in the same town and range, may be recorded on this certificate.

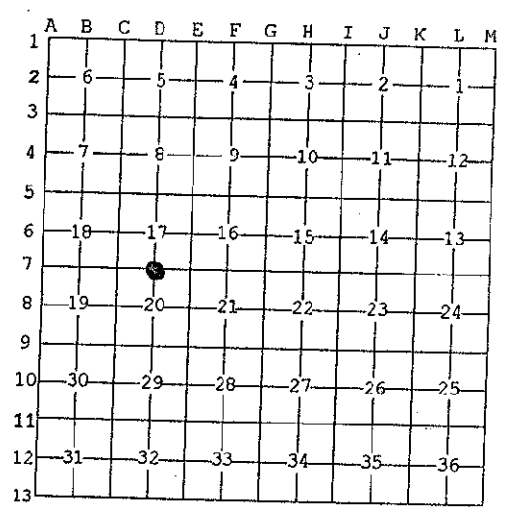

A. Description of original monument and accessories and/or subsequent restoration:

D-7	1830	GL0	Mullett	Set Post
	1935	Kent Co. Wit.		Conc. Mon.
	1974	LCRC #772	Nederveid	1/2" Round Iron
	1980	LCRC #1402	Merdziski	5/8" Iron
	1981	LCRC #2261	Merdzinski	Set Kent County Monument
	1995	LCRC #8188	Breitels	Kent County Monument

The position of this corner was previously approved by the Kent County Remonumentation Peer Group, monumented by John A. Merdzinski on 6/19/81 and was recorded per LCRC #2261

B. Description of corner evidence found and/or method applied in restoring or reestablishing corner:


D-7 Found standard Kent Co. Mon. (Harrison) per witnesses from above LCRC as set by John A. Merdzinski in place of the 5/8" Iron he found over a conc. mon. Said Iron and conc. mon. check with Kent Co. Wit. & LCRC's #772 and #1402.

LCRC #2261	Nail/tag 24" Walnut North 39.08'	C/L sign post	LCRC #8186	Nail/tag PP S55°E 55.33'
	Nail/tag 12" Maple N30°E 75.43'	S50°W 43.15'		Nail/tag 28" Walnut N00°E 39.11'
	Nail/tag P. Pole S55°E 55.30'			Nail/tag 18" Maple N30°E 75.50'
	Nail/tag 14" Walnut S25°E 69.80'			Nail/tag dbl. 24" Elm S50°W 70.19'
	Nail/tag 6" B. Elder N30°W 54.74'			Nail/tag 24" Walnut S25°E 69.69'
				Nail/tag 15" B. Elder N30°W 55.23'

The selected location is accepted by me and is generally accepted by professional surveyors as the best available evidence of the position of the original corner.

C. Description of monument for corner and accessories established to perpetuate locating the position of the corner:

D-7 Standard Kent County Monument	
Nail & KC Remon. tag W. side 28" dead Walnut	N00°E 39.11'
Nail & KC Remon. tag S. side 18" Maple	N60°E 75.50'
Nail & KC Remon. tag NE side P. Pole	S55°E 55.33'
Nail & KC Remon. tag W. side 24" Walnut	S25°E 69.69'
Nail & KC Remon. tag E. side 15" Box Elder	N30°W 55.23'
Nail & KC Remon. tag SE side double 24" Elm	S50°W 70.19'
Capped Iron (Chettleburgh)	N00°E 33.00'
C/L E-W blktp. road North 3' m/l; On C/L gravel road South	

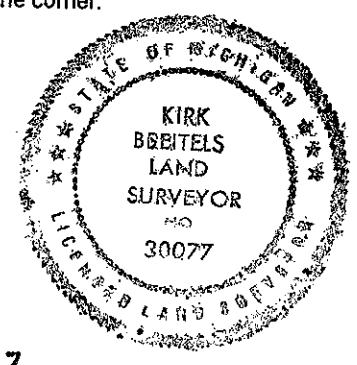

Signed by Kirk Breitels
Surveyor's Michigan License No. 30077

Date 3/27/97

P.A. 345 1990 KENT COUNTY
PEER APPROVED 3/27/97
CHAIRMAN Harry Kubes