

**KENT COUNTY REMONUMENTATION
LAND CORNER RECORDATION CERTIFICATE**
Filing Requirement of Act 74, Mich. P.A. 1970

STATE OF MICHIGAN
COUNTY OF KENT
RECEIVED FOR RECORD
93 DEC 20 AM 11:57

For corners in

Kent
(County)

Located In:

Corner Code #:

- | | | |
|------------------------------------|-------------------------|-------------------|
| 1. Public Land Survey | T <u>6N</u> R <u>9W</u> | <u>D-10</u> |
| | T _____ R _____ | <u>Center</u> |
| | T _____ R _____ | <u>Section 29</u> |
| | T _____ R _____ | <u>Lowell</u> |
| 2. Property Controlling in Section | S _____ T _____ R _____ | <u>Township</u> |
| | S _____ T _____ R _____ | |
| 3. Miscellaneous | S _____ T _____ R _____ | |
| Property in Sec. | S _____ T _____ R _____ | |

W. J. Bond
REG. OF DEEDS

6857

Register of Deeds Stamp & File Number

4. Lot No. _____, Recorded Plat _____
5. Private Claims _____

A	B	C	D	E	F	G	H	I	J	K	L	M
2	6	5	4	3	2	1						
3												
4	7	8	9	10	11	12						
5												
6	18	17	16	15	14	13						
7												
8	19	20	21	22	23	24						
9												
10	30	●	28	27	26	25						
11												
12	31	32	33	34	35	36						
13												

Thomas W.

Chettleburgh

I, Thomas W. Chettleburgh in a field survey on November 30, 19 93 do hereby certify that under requirements of P.A. 74, Michigan P.A. of 1970, the corner points mentioned in lines 1 and 2 above were in conformance with regulations and rules therefore as required in the current manual of survey instructions of the United States Department of the Interior, Bureau of Land Management or by a decree of a Court of Law and/or that the corner points mentioned in lines 3, 4 and 5 above were in conformance with the rules of the Michigan Board of Land Surveyors or by a Decree of a Court of Law; established, re-established, monumented, re-monumented, recovered, found as expressed below:

NOTE: Not more than 4 corners, all in the same town and range, may be recorded on this certificate.

A. Description of original monument and accessories and/or subsequent restoration:

W & W 1928, Held 1/4 line fence intersection for corner
West 1/4 Corner Section 29 2660'
North 1/4 Corner Section 29 2682.6'


B. Description of corner evidence found and/or method applied in restoring or reestablishing corner:

Hold intersection of 1/4 lines for corner
North 1/4 corner Section 29 (D-9) N00°33'52"E 2629.84'
East 1/4 corner Section 29 (E-10) S89°44'57"E 2617.92'
South 1/4 corner Section 29 (D-11) S00°33'52"W 2654.45'
West 1/4 corner Section 29 (C-10) N89°44'57"W 2640.60'

Set 4"X30" Harrison Monument at intersection of 1/4 lines

C. Description of monument for corner and accessories established to perpetuate locating the position of the corner:

4"X30" Harrison Monument
Nail/Tag SE side 18" Cottonwood S73°W 13.27'
Nail/Tag NW side 18" Cottonwood S22°W 78.23'
Nail/Tag W side 11" Maple S14°E 52.48'
Nail/Tag SW side 20" Cottonwood S80°E 36.74'
E - W R.O.W. Fence Line I-96 South 1.00'

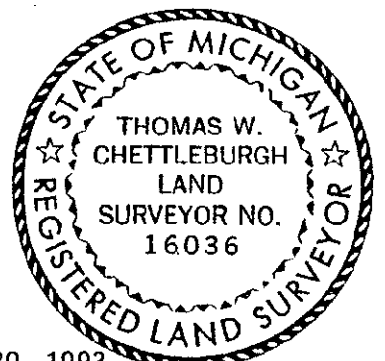

Signed by Thomas W. Chettleburgh Date December 20, 1993
Surveyor's Michigan License No. 16036