

SURVEY & REMONUMENTATION

MAR 03 1998

KENT COUNTY REMONUMENTATION

SECTION

LAND CORNER RECORDATION CERTIFICATE
Filing Requirement of Act 74, Mich. P.A. 1970

For corners in

KENT COUNTY

(County)

Located In:

Corner Code #

1. Public Land Survey	T 6N R 9W	D-11
	T R	
	T R	
	T R	
2. Property Controlling in Section	S T R	
	S T R	
3. Miscellaneous Property in Sec.	S T R	
	S T R	

STATE OF MICHIGAN
COUNTY OF KENT
RECEIVED FOR RECORD

97 JUN -3 AM 8:11

REG. OF DEEDS

9990

Register of Deeds Stamp & File Number

4. Lot No. _____, Recorded Plat _____
5. Private Claims _____

I, Kirk Breitels, in a field survey on Apr. 14, 1997 do hereby state that under requirements of P.A. 74, Michigan P.A. of 1970, the corner points mentioned in lines 1 and 2 above were in conformance with regulations and rules therefore as required in the current manual of survey instructions of the United States Department of the Interior, Bureau of Land Management or by a decree of a Court of Law and/or that the corner points mentioned in lines 3, 4 and 5 above were in conformance with the rules of the Michigan Board of Land Surveyors or by a Decree of a Court of Law; established, re-established, monumented, recovered, found as expressed below:

NOTE: Not more than 2 corners, all in the same town and range, may be recorded on this certificate.

A	B	C	D	E	F	G	H	I	J	K	L	M
1												
2	6	5	4	3	2	1						
3												
4	7	8	9	10	11	12						
5												
6	18	17	16	15	14	13						
7												
8	19	20	21	22	23	24						
9												
10	30	29	28	27	26	25						
11												
12	31	32	33	34	35	36						
13												

A. Description of original monument and accessories and/or subsequent restoration:

D-11	1830	GLO	Mullett	Set Post
	1964	Kent Co. Wit.		"T" Iron
	1985	LCRC #4204	Rosema	Set Kent County Monument
	1991	LCRC #5741	Bueche	Reset Kent Co. Monument
	1995	LCRC #8190	Breitels	Reset Kent Co. Monument

The position of this corner was previously approved by the Kent County Remonumentation Peer Group, monumented by Maurice J. Rosema on 2/7/85 and was recorded per LCRC #4204.

B. Description of corner evidence found and/or method applied in restoring or reestablishing corner:


D-11 Found standard Kent Co. Mon. (Harrison) per witnesses from above LCRC as set by John C. Bueche & Kirk Breitels in the same location as set by Maurice J. Rosema in place of the 1/2" Iron he found inside a mon. box. Said Iron checks with Kent Co. Wit.

<u>LCRC #4204 & #5741</u>		<u>LCRC #8190</u>	
Nail & tag 24" Oak	N03°E 36.39'	Nail & tag 30" Oak	N03°E 36.36'
Nail & tag 30" Oak	N13°E 62.88'	Nail & tag 8" Ash	N60°W 94.62'
Nail & tag 5" Ash	N60°W 94.62'	Nail & tag Tri. 30" Oak	S00°E 60.16'
Nail & tag Tri. 30" Oak	S00°E 60.12'	Nail & tag P. Pole	S66°E 70.75'
Nail & tag P. Pole	S66°E 70.71'		

The selected location is accepted by me and is generally accepted by professional surveyors as the best available evidence of the position of the original corner.

C. Description of monument for corner and accessories established to perpetuate locating the position of the corner:

D-11 Standard Kent County Monument	
Nail & Remon. tag W. side 30" Oak	N03°E 36.33'
Nail & Remon. tag S. side 8" Ash	N60°W 94.54'
Nail & Remon. tag E. side Tri. 30" Oak	S00°E 60.20'
Nail & Remon. tag N. side P. Pole	S66°E 70.78'
C/L E-W B.T. road - North 1.5'	
On fence line to N	

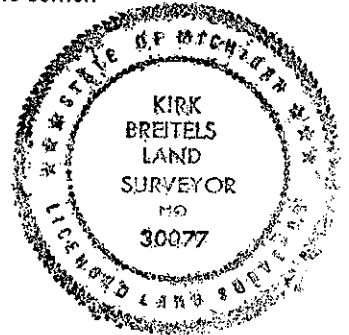

Signed by Kirk Breitels
Surveyor's Michigan License No. 30077

Date 5/22/97

P.A. 345 1990 KENT COUNTY

PEER APPROVED 5/22/97
CHAIRMAN Harold K. ...