

1/2

# SURVEY & REMONUMENTATION

MAR 03 1998

## KENT COUNTY REMONUMENTATION

### LAND CORNER RECORDATION CERTIFICATE Filing Requirement of Act 74, Mich. P.A. 1970

#### SECTION

For corners in  
KENT COUNTY

Located In:	Corner Code #
T 6N R 9W	D-12
T R	
T R	
T R	
T R	
S T R	
S T R	
S T R	
S T R	

1. Public Land Survey

2. Property Controlling in Section

3. Miscellaneous Property in Sec.

4. Lot No. \_\_\_\_\_, Recorded Plat \_\_\_\_\_  
5. Private Claims \_\_\_\_\_

REG. OF DEEDS

97 OCT 14 AM 10:32

STATE OF MICHIGAN  
COUNTY OF KENT  
RECEIVED FOR RECORDING

10064

Register of Deeds Stamp & File Number

I, Kirk Breitels, in a field survey on July 14, 1997 do hereby state that under requirements of P.A. 74, Michigan P.A. of 1970, the corner points mentioned in lines 1 and 2 above were in conformance with regulations and rules therefore as required in the current manual of survey instructions of the United States Department of the Interior, Bureau of Land Management or by a decree of a Court of Law and/or that the corner points mentioned in lines 3, 4 and 5 above were in conformance with the rules of the Michigan Board of Land Surveyors or by a Decree of a Court of Law; established, re-established, monumented, recovered, found as expressed below:

	A	B	C	D	E	F	G	H	I	J	K	L	M
1													
2	6		5		4		3		2		1		
3													
4	7		8		9		10		11		12		
5													
6	10		17		16		15		14		13		
7													
8	19		20		21		22		23		24		
9													
10	30		29		28		27		26		25		
11													
12	31		32		33		34		35		36		
13													

NOTE: Not more than 2 corners, all in the same town and range, may be recorded on this certificate.

A. Description of original monument and accessories and/or subsequent restoration:

D-12 1830---GLO---Not Set  
1953---Williams & Works---Fence Corner  
Kent Co. Wits.---No information

P.A. 345 1990 KENT COUNTY  
PEER APPROVED 7/24/97

CHAIRMAN Harry Hubert


B. Description of corner evidence found and/or method applied in restoring or reestablishing corner:  
D-12 Established Intersection of 1/4 lines and found extension of fence lines N-S & E-W to be approx. 4' E. and 3' S. of this location. Dimensions and angles agree with All Points survey in NW 1/4.

No other information found.

The Intersection of 1/4 lines is accepted by me and is generally accepted by professional surveyors as the best available evidence of the position of the corner.

C. Description of monument for corner and accessories established to perpetuate locating the position of the corner:  
D-12 Set Standard Kent Co. Monument (Harrison) at the Intersection of 1/4 lines

Nail & KC Remon. tag W. side 8" Hickory	S15°W	79.32'
Nail & KC Remon. tag NW side 18" Oak	N40°E	69.33'
Nail & KC Remon. tag E. side Tw. 18" Basswood	N15°W	12.01'
Nail & KC Remon. tag N. side 12" Hickory	S90°W	26.14'
Nail & KC Remon. tag E. side 32" Hickory	S10°W	21.81'
Nail & KC Remon. tag N. side 36" Oak	N70°E	14.02'
Mon. at NE side of field drive NW-SE		

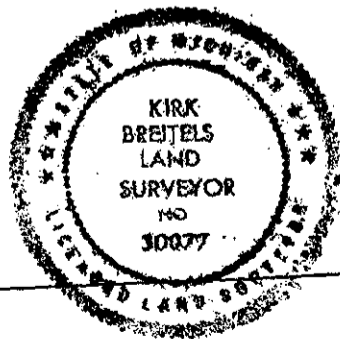

Signed by

Kirk Breitels

Date

9/22/97

Surveyor's Michigan License No.

30077