

SURVEY & REMONUMENTATION

MAR 03 1998

KENT COUNTY REMONUMENTATION

SECTION

LAND CORNER RECORDATION CERTIFICATE
Filing Requirement of Act 74, Mich. P.A. 1970

For corners in

KENT COUNTY

(County)

Located In:

Corner Code #

- | | | |
|------------------------------------|--|------------|
| 1. Public Land Survey | T <u>6N</u> R <u>9W</u> | <u>E-1</u> |
| | T <u> </u> R <u> </u> | <u> </u> |
| | T <u> </u> R <u> </u> | <u> </u> |
| | T <u> </u> R <u> </u> | <u> </u> |
| 2. Property Controlling in Section | S <u> </u> T <u> </u> R <u> </u> | <u> </u> |
| | S <u> </u> T <u> </u> R <u> </u> | <u> </u> |
| 3. Miscellaneous Property in Sec. | S <u> </u> T <u> </u> R <u> </u> | <u> </u> |
| | S <u> </u> T <u> </u> R <u> </u> | <u> </u> |

STATE OF MICHIGAN
COUNTY OF KENT
RECEIVED FOR RECORD
97 APR 29 AM 8:21
REG. OF DEEDS
Luis St. Paul

9817

Register of Deeds Stamp & File Number

4. Lot No. _____, Recorded Plat _____
5. Private Claims _____

I, Kirk Breitels, in a field survey on Jan. 6, 1997 do hereby state that under requirements of P.A. 74, Michigan P.A. of 1970, the corner points mentioned in lines 1 and 2 above were in conformance with regulations and rules therefore as required in the current manual of survey instructions of the United States Department of the Interior, Bureau of Land Management or by a decree of a Court of Law and for that the corner points mentioned in lines 3, 4 and 5 above were in conformance with the rules of the Michigan Board of Land Surveyors or by a Decree of a Court of Law, established, re-established, monumented, recovered, found as expressed below:

1	A	B	C	D	E	F	G	H	I	J	K	L	M
2	6		5		4		3		2		1		
3													
4	7		8		9		10		11		12		
5													
6	18		17		16		15		14		13		
7													
8	19		20		21		22		23		24		
9													
10	30		29		28		27		26		25		
11													
12	31		32		33		34		35		36		
13													

NOTE: Not more than 2 corners, all in the same town and range, may be recorded on this certificate.

A. Description of original monument and accessories and/or subsequent restoration:

- | | | | | |
|-----|---------|------------------|---------|--------------------------|
| E-1 | 1830 | GLO | Mullett | Set Post |
| | 1937 | Kent Co. Wit. | | Leaded Stone |
| | 1947-63 | Williams & Works | | Leaded Stone |
| | 1985 | LCRC #4145 | Rosema | Set Kent County Monument |
| | 1991 | LCRC #5849 | Unema | Kent County Monument |

The position of this corner was previously approved by the Kent County Remonumentation Peer Group, monumented by Maurice J. Rosema on 2/6/91 and was recorded per LCRC #5849

B. Description of corner evidence found and/or method applied in restoring or reestablishing corner:


E-1 Found standard Kent Co. Mon. (Harrison) per witnesses from above LCRC as set by Maurice J. Rosema on Twp. line in place of the Boat Spike he found over a large stone. Said Boat Spike checks with Kent Co. Wit. and Williams & Works information.

- | | | | | |
|-----------------------|-------------------|-----------------------|---------------|----------------|
| <u>LCRC #4145</u> | <u>LCRC #5849</u> | | | |
| Nail & tag 18" Ash | S65°W 59.96' | Nail & tag P. Pole | S72°E 116.25' | KCM (E-1, 7-9) |
| Nail & tag 18" Oak | N10°W 33.65' | Nail & tag 24" Oak | N14°W 33.70' | East 52.76' |
| Nail & tag 24" Oak | N58°E 103.01' | Nail & tag 24" Oak | N55°E 103.02' | |
| Nail & tag fence post | S31°E 48.89' | Nail & tag 20" Ash | S60°W 59.93' | |
| KC Mon. (E-13, 7-9) | East 52.80' | Nail & tag Cl. 8" Elm | N06°W 73.99' | |

The selected location is accepted by me and is generally accepted by professional surveyors as the best available evidence of the position of the original corner.

C. Description of monument for corner and accessories established to perpetuate locating the position of the corner:

- | | |
|--|---------------|
| E-1 Standard Kent County Monument | |
| Nail & KC Remon. tag N. side P. Pole | S72°E 116.21' |
| Nail & KC Remon. tag E. side 28" Oak | N14°W 33.60' |
| Nail & KC Remon. tag NW side 30" Oak | N55°E 103.13' |
| Nail & KC Remon. tag NW side 22" Ash | S60°W 59.93' |
| Nail & KC Remon. tag E. side Clump 6"-10" Elms | N06°W 73.49' |
| Kent Co. Mon. (E-13, T7N, R9W) | East 52.76' |
| C/L "X" of BT roads is East 19'± | |

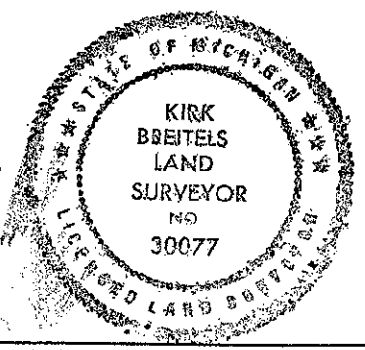

Signed by *Kirk Breitels*
Surveyor's Michigan License No. 30077

Date 3/27/97

P.A. 345 1990 KENT COUNTY
PEER APPROVED 3/27/97
CHAIRMAN *Harry Hakee*