

MAR 03 1998

KENT COUNTY REMONUMENTATION

SECTION

LAND CORNER RECORDATION CERTIFICATE
Filing Requirement of Act 74, Mich. P.A. 1970

For corners in
KENT COUNTY

(County)

Located In:

Corner Code #

1. Public Land Survey	T 6N	R 9W	E-2
	T	R	
	T	R	
	T	R	
2. Property Controlling in Section	S	T	R
	S	T	R
3. Miscellaneous Property in Sec.	S	T	R
	S	T	R

REG. OF DEEDS

Lucy Bond

97 APR 29 AM 8:21

STATE OF MICHIGAN
COUNTY OF KENT
RECEIVED FOR RECORD

9818

Register of Deeds Stamp & File Number

4. Lot No. _____, Recorded Plat _____
5. Private Claims _____

A	B	C	D	E	F	G	H	I	J	K	L	M
1												
2	6		5	●	4		3		2		1	
3												
4	7		8		9		10		11		12	
5												
6	18		17		16		15		14		13	
7												
8	19		20		21		22		23		24	
9												
10	30		29		28		27		26		25	
11												
12	31		32		33		34		35		36	
13												

I, Kirk Breitels, in a field survey on Jan. 10, 1997 do hereby state that under requirements of P.A. 74, Michigan P.A. of 1970, the corner points mentioned in lines 1 and 2 above were in conformance with regulations and rules therefore as required in the current manual of survey instructions of the United States Department of the Interior, Bureau of Land Management or by a decree of a Court of Law and/or that the corner points mentioned in lines 3, 4 and 5 above were in conformance with the rules of the Michigan Board of Land Surveyors or by a Decree of a Court of Law; established, re-established, monumented, recovered, found as expressed below:

NOTE: Not more than 2 corners, all in the same town and range, may be recorded on this certificate.

A. Description of original monument and accessories and/or subsequent restoration:

E-2	1830	GLO	Mullett	Set Post
	1937	Kent Co. Wit.		Leaded Stone
	1976	LCRC #991	Nederveld	Leaded Stone
	1980	LCRC #1477	Merdzinski	Set Kent County Monument
	1990	LCRC #5740	Bueche	Reset Kent County Monument
	1995	LCRC #8191	Breitels	Kent County Monument

The position of this corner was previously approved by the Kent County Remonumentation Peer Group, monumented by John A. Merdzinski on 11/24/80 and was recorded per LCRC #1477

B. Description of corner evidence found and/or method applied in restoring or reestablishing corner:


E-2 Found standard Kent Co. Mon. (Harrison) per witnesses from above LCRC as set by John C. Bueche in same location as set in 1980 by John A. Merdzinski in place of the Stone he found. Said Stone checks with Kent Co. Wit. and LCRC #991.

<u>LCRC #1477</u>	Tag & Nail P. Pole	N85°W	41.96'	
	Tag & Nail P. Pole	N25°W	102.55'	Iron (Hay)
	SE cor. hse. #1607	S60°W	100.80'	N90°E
	NW cor. hse. #1632	S30°E	192.84'	32.94'
	C/L fire hydrant	S80°W	24.61'	
<u>LCRC #5740</u>	same witnesses as LCRC #1477			
<u>LCRC #8191</u>	same witnesses as LCRC #5740			

The selected location is accepted by me and is generally accepted by professional surveyors as the best available evidence of the position of the original corner.

C. Description of monument for corner and accessories established to perpetuate locating the position of the corner:

E-2 Standard Kent County Monument				
KC Remon. tag & Nail N. side P. Pole	N85°W	41.92'		
KC Remon. tag & Nail NE side P. Pole	N25°W	102.55'		
SE cor. hse. #1607 frame	S60°W	100.82'		
NW cor. hse. #1632 frame	S30°E	192.84'		
Iron	N90°E	33.00'		
C/L top fire hydrant	S80°W	24.61'		
C/L Bit. Rd. N-S is 1' N; Tree line W				

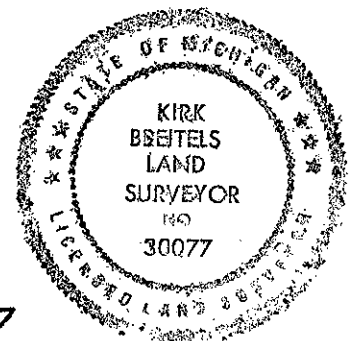

Signed by *Kirk Breitels*
Surveyor's Michigan License No. 30077

Date 3/27/97

P.A. 345 1990 KENT COUNTY
PEER APPROVED 3/27/97
CHAIRMAN *Henry Hubert*