

**SURVEY & REMONUMENTATION**

MAR 03 1998

KENT COUNTY REMONUMENTATION

**SECTION**

**LAND CORNER RECORDATION CERTIFICATE**  
Filing Requirement of Act 74, Mich. P.A. 1970

For corners in  
KENT COUNTY

(County)

Located in:

Corner Code #

1. Public Land Survey	T <u>6N</u>	R <u>9W</u>	E-3
	T	R	
	T	R	
	T	R	
2. Property Controlling in Section	S	T	R
	S	T	R
3. Miscellaneous Property in Sec.	S	T	R
	S	T	R

REG. OF DEEDS

*Lucy Bond*

97 APR 29 AM 8:21

STATE OF MICHIGAN  
COUNTY OF KENT  
RECEIVED FOR RECORD

9819

Register of Deeds Stamp & File Number

4. Lot No. \_\_\_\_\_, Recorded Plat \_\_\_\_\_  
5. Private Claims \_\_\_\_\_

	A	B	C	D	E	F	G	H	I	J	K	L	M
1													
2	6		5		4		3		2		1		
3													
4	7		8		9		10		11		12		
5													
6	18		17		16		15		14		13		
7													
8	19		20		21		22		23		24		
9													
10	30		29		28		27		26		25		
11													
12	31		32		33		34		35		36		
13													

I, Kirk Breitels, in a field survey on Jan. 10, 1997 do hereby state that under requirements of P.A. 74, Michigan P.A. of 1970, the corner points mentioned in lines 1 and 2 above were in conformance with regulations and rules therefore as required in the current manual of survey instructions of the United States Department of the Interior, Bureau of Land Management or by a decree of a Court of Law and/or that the corner points mentioned in lines 3, 4 and 5 above were in conformance with the rules of the Michigan Board of Land Surveyors or by a Decree of a Court of Law; established, re-established, monumented, recovered, found as expressed below:

NOTE: Not more than 2 corners, all in the same town and range, may be recorded on this certificate.

A. Description of original monument and accessories and/or subsequent restoration:

E-3	1830	GLO	Mullett	Set Post
	1970	Kent Co. Wit.		3/4" Iron
	1984	LCRC #3877		Set "T" Iron
	1985	LCRC #4137	Rosema	Set Kent County Monument
	1995	LCRC #8192	Breitels	Kent County Monument

The position of this corner was previously approved by the Kent County Remonumentation Peer Group, monumented by Maurice J. Rosema on 11/20/84 and was recorded per LCRC #4137

B. Description of corner evidence found and/or method applied in restoring or reestablishing corner:

E-3 Found standard Kent Co. Mon. (Harrison) per witnesses from above LCRC as set by Maurice J. Rosema in place of the "T" Iron he found. Said "T" Iron checks with Kent Co. Wit. & LCRC #3877.

LCRC #4137

PK Nail & tag in curb joint	S23°W	55.43'
Nail & tag 6" Willow	N58°E	42.80'
Nail & tag 36" Oak	N05°W	235.21'
PK Nail NW cor. gutter pan	S21°E	48.71'
Nail & tag 6" Poplar	S64°W	57.90'

LCRC #8192


Nail & tag 6" Willow	N58°E	42.95'
Nail & tag cl. 8" Elm	S70°E	51.16'
Nail & tag Guy Pole	S35°W	74.48'
SE cor. last fc. post	N40°W	69.09'

The selected location is accepted by me and is generally accepted by professional surveyors as the best available evidence of the position of the original corner.

C. Description of monument for corner and accessories established to perpetuate locating the position of the corner:

E-3 Standard Kent County Monument

Nail & KC Remon. tag NW side 6" Willow	N58°E	42.95'
Nail & KC Remon. tag S. side cluster 8" Elm	S70°E	51.16'
Nail & KC Remon. tag E. side P. Pole	S30°W	74.54'
SE corner last wood fence post	N40°W	69.09'
On C/L N-S B.T. roadway		

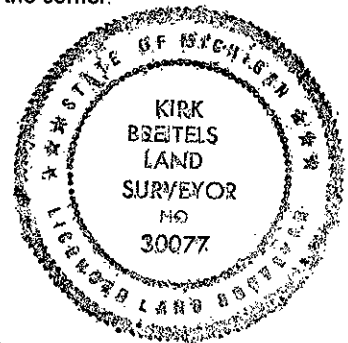

Signed by Kirk Breitels

Date 3/27/97

Surveyor's Michigan License No. 30077

P.A. 345 1990 KENT COUNTY

PEER APPROVED 3/27/97

CHAIRMAN Farmacy Hubert

FORM APPROVED BY MICHIGAN STATE BOARD OF PROFESSIONAL SURVEYORS, JAN. 28, 1971

REVISED MAY 14, 1975

REVISED JAN., 1983

REVISED OCT., 1985