

SURVEY & REMONUMENTATION

MAR 03 1998

KENT COUNTY REMONUMENTATION

SECTION

LAND CORNER RECORDATION CERTIFICATE
Filing Requirement of Act 74, Mich. P.A. 1970

For corners in
KENT COUNTY
(County)

Located In:	Corner Code #
1. Public Land Survey T6N R9W	E-4
T R	
T R	
T R	
2. Property Controlling in Section S T R	
S T R	
3. Miscellaneous Property in Sec. S T R	
S T R	

STATE OF MICHIGAN
COUNTY OF KENT
RECEIVED FOR RECORD

97 JUN -3 AM 8:11


REG. OF DEEDS

9991

Register of Deeds Stamp & File Number

4. Lot No. _____, Recorded Plat _____
5. Private Claims _____

I, Kirk Breitels, in a field survey on May 12 1997 do hereby state that under requirements of P.A. 74, Michigan P.A. of 1970, the corner points mentioned in lines 1 and 2 above were in conformance with regulations and rules therefore as required in the current manual of survey instructions of the United States Department of the Interior, Bureau of Land Management or by a decree of a Court of Law and/or that the corner points mentioned in lines 3, 4 and 5 above were in conformance with the rules of the Michigan Board of Land Surveyors or by a Decree of a Court of Law; established, re-established, monumented, recovered, found as expressed below:

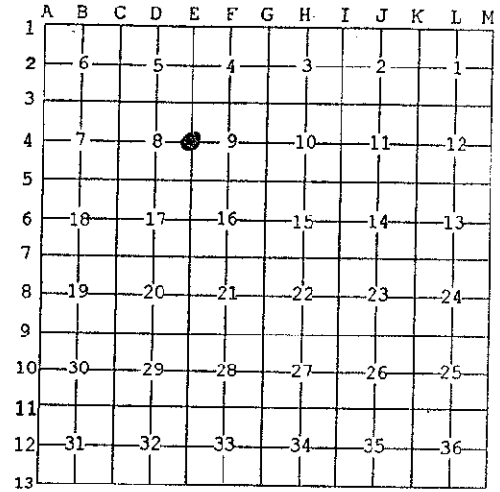

NOTE: Not more than 2 corners, all in the same town and range, may be recorded on this certificate.

A. Description of original monument and accessories and/or subsequent restoration:

Corner Code	Year	Monument	Restoration
E-4	1830	GLO Mullett	Set Post
		Kent Co. Wit.	Iron
	1973	LCRC #545 Spicer	"T" Iron
	1982	LCRC #2721 Merdzinski	Set Kent County Monument
	1995	LCRC #8193 Breitels	Kent County Monument

The position of this corner was previously approved by the Kent County Remonumentation Peer Group, monumented by John A. Merdzinski on 2/23/82 and was recorded per LCRC #2721

B. Description of corner evidence found and/or method applied in restoring or reestablishing corner:

E-4 Found BROKEN standard Kent Co. Mon. (Harrison) per witnesses from above LCRC as set by John A. Merdzinski in place of the "T" Iron over 1" Iron he found in a stone pile. Both Irons check with Kent Co. Wit. & LCRC #545. Removed broken portion, added risers and reset per witnesses.


LCRC #2721	LCRC #8193
Nail & tag 34" Cherry S15°E 98.90'	Nail & tag 40" Cherry S15°E 98.95'
Nail & tag P. Pole S15°W 87.79'	Nail & tag P. Pole S15°W 87.74'
Nail & tag 10" Oak N85°W 53.97'	Nail & tag 16" Walnut N85°W 54.07'
Nail & tag 14" Spruce S50°E 45.63'	Nail & tag 18" Spruce S50°E 45.70'
SE cor. brick chimney N55°E 88.90'	SE cor. brick chimney N55°E 88.94'

The selected location is accepted by me and is generally accepted by professional surveyors as the best available evidence of the position of the original corner.

C. Description of monument for corner and accessories established to perpetuate locating the position of the corner:

E-4 Standard Kent County Monument

Nail & KC Remon. tag W. side 40" W. Cherry	S15°E	98.95'
Nail & KC Remon. tag E. side P. Pole	S15°W	87.74'
Nail & KC Remon. tag N. side 16" Walnut	N85°W	54.07'
Nail & KC Remon. tag NW side 18" Spruce	S50°E	45.70'
SE corner brick chimney to house	N55°E	88.94'
On C/L grav. dr.; on tree line West; C/L RR 150'± South		

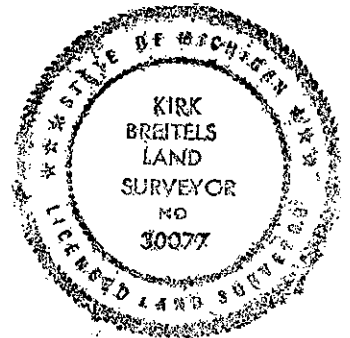

Signed by Kirk Breitels

Date 5/22/97

Surveyor's Michigan License No. 30077
P.A. 345 1990 KENT COUNTY

PEER APPROVED 5/22/97
CHAIRMAN Harry Hubert